

Lowndes
G 56
2-25-70

MISSISSIPPI
BOARD OF WATER COMMISSIONERS
416 North State Street
Jackson, Mississippi 39201

CODED

WATER WELL DRILLERS LOG

2-25 1970 W.J. REEVES & SON LOWNDES
date well completed firm name county well located

LANDOWNER: FLOYD FIELDS
KERR. COLOR
402 TUSCA LOOSA RD.
COLUMBUS, MISS.
(mailing address)

description of formations encountered	from	to
SANDY CLAY	0	3
SAND & GRAVEL	3	25
BLUE CLAY	25	37
" SAND	37	39
" CLAY	39	60
" SAND	60	65
" CLAY	65	72
" SAND	72	76
" CLAY	76	85
" SAND	85	85
" CLAY	85	98
" SAND	98	109
" CLAY	109	110

WELL LOCATION:
sec. 11 T 18 R 18
1/2 miles E of COLUMBUS
(distance) (direction) (nearest town)

WELL PURPOSE: HOME
(home, irrigation, municipal, industrial)

WELL COMPLETION DATA:
(1) diameter (inches) 4
(2) total depth (feet) 110
(3) static water level (feet) 8 below top of ground.
(4) casing STEEL 32 1/2' (material) (depth)
4" (size) if telescope see back.
(5) screen NONE (length) (depth to top)
(size) (material)
(6) pump 1/3 (HP) 7 (yield gpm)
ELECT (type power)
(7) electric log NO (yes or no)
(organization running log)
(8) how well bottom plugged OPEN


APR - 2 1970

MISS. BD. OF
WATER COMM.

DRILLERS REMARKS:

If well telescopes please sketch and show depths.

GROUND LEVEL

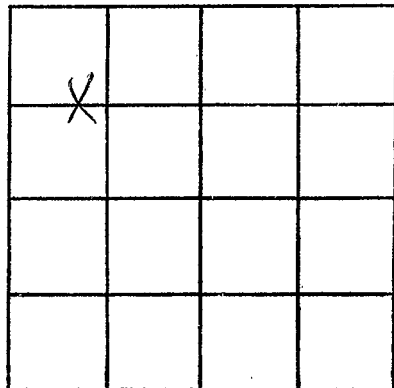

SECTION 11

Please indicate well location X.

ADDITIONAL INFORMATION

If more than one screen, show locations of each on sketch.