

Lowndes
 G-58
 4-6-70

MISSISSIPPI
 BOARD OF WATER COMMISSIONERS
 416 North State Street
 Jackson, Mississippi 39201
 WATER WELL DRILLERS LOG

CODED

4-6-70 19 Columbus Well Drilling Lowndes
 date well completed firm name county well located

LANDOWNER: J. A. Gore
 Pickensville Road 3285742

Columbus, Miss.
 (mailing address)

WELL LOCATION:
 NW 27 sec 22 T 18 N R 18 E
 S
 3 miles South of Columbus
 (distance) (direction) (nearest town)

WELL PURPOSE: home
 (home, irrigation, municipal, industrial)

WELL COMPLETION DATA:

- (1) diameter (inches) 4"
- (2) total depth (feet) 168
- (3) static water level (feet) 16 below top of ground
- (4) casing Steel 22 (material) (depth)
 (size) If telescope see back.
- (5) screen No (length) (depth to top)
 (size) (material)
- (6) pump No (HP) (yield gpm)
 (type power)
- (7) electric log No (yes or no)
 (organization running log)
- (8) how well bottom plugged Open

description of formations encountered	from	to
Sand and gravel	0	21
Blue clay	21	42
Blue clay, some sand	42	63
Clay and sand	63	84
Clay and sand	84	105
Clay, sand and rock	105	126
clay, sand and rock	126	147
Clay, rock	147	168

CODED


APR 23 1970

MISS. BD. OF
 WATER COMM

DRILLERS REMARKS:

If well telescopes please sketch and show depths.

GROUND LEVEL

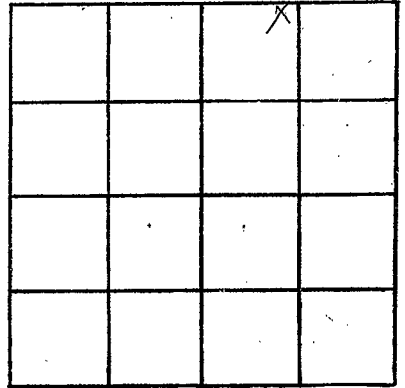

SECTION 27

Please indicate well location X.

ADDITIONAL INFORMATION

If more than one screen, show locations of each on sketch.