

Lowndes Co.
G 59
4-22-70

MISSISSIPPI
BOARD OF WATER COMMISSIONERS
416 North State Street
Jackson, Mississippi 39201

WATER WELL DRILLERS LOG

4/22 1970 ALLSUP DRILLING CO. LOWNDES
date well completed firm name county well located

LANDOWNER: COLUMBUS
Church of Christ
Columbus, Miss
2401 7th St N (mailing address)

description of formations
encountered

from

to

SAND	0	38
BLUE ROCK	38	76
SAND + ROCK	76	309
MUCK	309	347
SAND	347	408

WELL LOCATION:

4th T 18th R 18th WEST
In City Limits Columbus
(distance) (direction) (nearest town)

WELL PURPOSE: CHURCH USE
(home, irrigation, municipal, industrial)

WELL COMPLETION DATA:

- (1) diameter (inches) 4" x 2"
(2) total depth (feet) 408
(3) static water level (feet) 12' below
top of ground.
4" - Plastic Top
(4) casing METAL 336
(material) (depth)

(size) If telescope see back.

- (5) screen 30' 378
(length) (depth to top)
2" COPPER
(size) (material)

- (6) pump 1 1/2
(HP) (yield gpm)
ELECTRIC
(type power)

- (7) electric log No
(yes or no)

(organization running log)

- (8) how well bottom plugged

SCREEN
PAINT

DRILLERS REMARKS:

MAY 22 1970

MISS. BD. OF
WATER COMM.

If well telescopes please sketch and show depths.

GROUND LEVEL


42' 4" CASING

38' ROCK

306' 2" CASING

30' COPPER SCREEN

If more than one screen, show locations of each on sketch.

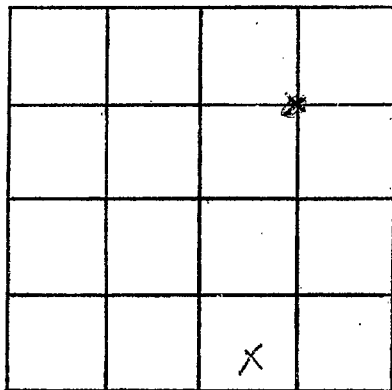

SECTION 04

Please indicate well location X.

ADDITIONAL INFORMATION