

MISSISSIPPI
BOARD OF WATER COMMISSIONERS
416 North State Street
Jackson, Mississippi 39201

CODED

WATER WELL DRILLERS LOG

LOWMEDES
G60
3-5-70

3-5 1970 W.J. REEVES & SON LOWMEDES
date well completed firm name county well located

LANDOWNER: A.C. WILLIAMS

description of formations encountered

from to

OLD MACON RD.
COLUMBUS 3286774
(mailing address)

<u>SANDY CLAY</u>	<u>0</u>	<u>9</u>
<u>SAND & GRAVEL</u>	<u>4</u>	<u>30</u>
<u>BLUE CLAY</u>	<u>30</u>	<u>108</u>
<u>" SAND</u>	<u>108</u>	<u>117</u>
<u>" CLAY</u>	<u>117</u>	<u>131</u>
<u>" SAND</u>	<u>131</u>	<u>143</u>
<u>" CLAY</u>	<u>143</u>	<u>151</u>
<u>" SAND</u>	<u>151</u>	<u>175</u>

WELL LOCATION:

sec. 29 T 19 N R 18 E
0 miles of COLUMBUS
(distance) (direction) (nearest town)

WELL PURPOSE: HOME
(home, irrigation, municipal, industrial)

WELL COMPLETION DATA:

- diameter (inches) 4
- total depth (feet) 175
- static water level (feet) 14 below above top of ground.
- casing STEEL 34
(material) (depth)
4 If telescope see back.
(size)
- screen NONE
(length) (depth to top)
(size) (material)
- pump _____
(HP) (yield gpm)
(type power)
- electric log NO
(yes or no)
(organization running log)
- how well bottom plugged OPEN

CODED


AUG 26 1970

DRILLERS REMARKS:

MISS. BD. OF
WATER COMM.

If well telescopes please sketch and show depths.

GROUND LEVEL

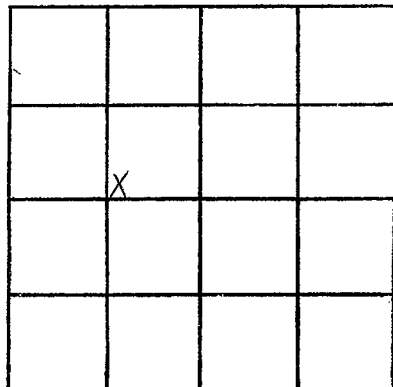

SECTION 29

Please indicate well location X.

ADDITIONAL INFORMATION

If more than one screen, show locations of each on sketch.