

LOWNDES

G61

6-19-70

MISSISSIPPI BOARD OF WATER COMMISSIONERS
416 North State Street
Jackson, Mississippi 39201

CODED

WATER WELL DRILLERS LOG

6-19 1970 W.J. REEVES & SON LOWNDES
date well completed firm name county well located

LANDOWNER: PAUL STOREY
328 3487

RT. 5 Plymouth Rd.

COLUMBUS
(mailing address)

WELL LOCATION:
17 1/2 sec. 21 T 18 N R 10 E
1 miles W of Col.
(distance) (direction) (nearest town)

WELL PURPOSE: HOME
(home, irrigation, municipal, industrial)

WELL COMPLETION DATA:

(1) diameter (inches) 4

(2) total depth (feet) 202

(3) static water level (feet) 28 below top of ground.

(4) casing STEEL 38
(material) (depth)

4 (size) if telescope see back.

(5) screen NONE
(length) (depth to top)

(size) (material)

(6) pump 1/2 10
(HP) (yield gpm)

ELECT
(type power)

(7) electric log NO
(yes or no)

(organization running log)

(8) how well bottom plugged OPEN

description of formations encountered	from	to
SANDY CLAY	0	8
SAND & GRAVEL	8	32
BLUE CLAY	32	130
" SAND	130	142
" CLAY	142	156
" SAND	156	162
" CLAY	162	170
" SAND	170	202

CODED


AUG 20 1970

MISS. BD. OF WATER COMMISSIONERS

DRILLERS REMARKS:

If well telescopes please sketch and show depths.

GROUND LEVEL

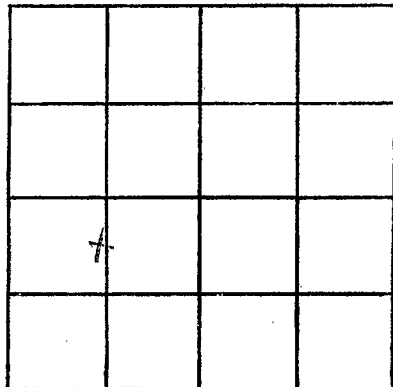

SECTION _____

Please indicate well location X.

ADDITIONAL INFORMATION

If more than one screen, show locations of each on sketch.