

LOWNDES
G 63
6-24-70

MISSISSIPPI
 BOARD OF WATER COMMISSIONERS
 416 North State Street
 Jackson, Mississippi 39201

CODED

WATER WELL DRILLERS LOG

6-24 1970 W. J. REEVES & SON LOWNDES
 date well completed firm name county well located

LANDOWNER: GLENN CARRETT

RT. 5 Plymouth RD.
32803R4

COLUMBUS
 (mailing address)

WELL LOCATION:
175 URBAN AREA
 sec. 15 T 18 R 5
1 miles W of COL.
 (distance) (direction) (nearest town)

WELL PURPOSE: HOME
 (home, irrigation, municipal, industrial)

WELL COMPLETION DATA:

- (1) diameter (inches) 4
- (2) total depth (feet) 200
- (3) static water level (feet) 22 below above top of ground.
- (4) casing STEEL 38
 (material) (depth)
4 If telescope see back.
 (size)
- (5) screen NONE
 (length) (depth to top)
 (size) (material)
- (6) pump NONE
 (HP) (yield gpm)
 (type power)
- (7) electric log NO
 (yes or no)
 (organization running log)
- (8) how well bottom plugged OPEN

description of formations encountered	from	to
SANDY CLAY	0	10
SAND & GRAVEL	10	33
BLUE CLAY	33	105
" SAND	105	112
" CLAY	112	135
" SAND	135	152
" CLAY	152	168
" SAND	168	200

CODED


AUG 26 1970

DRILLERS REMARKS:

MISS. BD. OF
 WATER

If well telescopes please sketch and show depths.

GROUND LEVEL

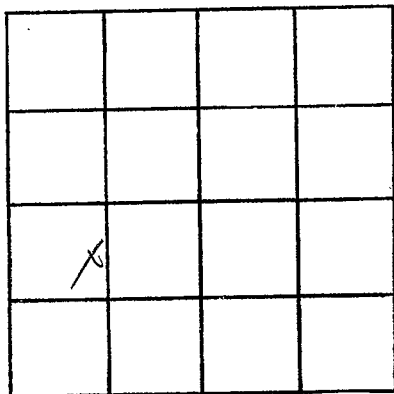

SECTION _____

Please indicate well location X.

ADDITIONAL INFORMATION

If more than one screen, show locations of each on sketch.