

LOWNDES

G 64

4-13-70

MISSISSIPPI BOARD OF WATER COMMISSIONERS

416 North State Street Jackson, Mississippi 39201

CODED

WATER WELL DRILLERS LOG

4-13 1970 W. J. REEVES & SON LOWNDES

date well completed

firm name

county well located

LANDOWNER: FIELDS BROS.

CLAY SYLVAN RD, 300 TUSCALOOSA RD.

COLUMBUS

(mailing address)

description of formations encountered

from

to

WELL LOCATION:

sec. 11 T-18 S R-18 E 1/2 miles E of Columbus (distance) (direction) (nearest town)

Table with 3 columns: description of formations encountered, from, to. Rows include SANDY CLAY, SAND & GRAVEL, BLUE CLAY, SAND, CLAY, SAND, CLAY, SAND.

WELL PURPOSE: HOME (home, irrigation, municipal, industrial)

WELL COMPLETION DATA:

- (1) diameter (inches) 4
(2) total depth (feet) 115
(3) static water level (feet) 5 below above top of ground.
(4) casing STEEL 32 1/2 (material) (depth)
(5) screen NONE (length) (depth to top)
(6) pump 1/3 (HP) 8 (yield gpm)
(7) electric log NO (yes or no)
(8) how well bottom plugged OPEN


CODED

DRILLERS REMARKS:

MISS. Bd. of WATER COMM.

If well telescopes please sketch and show depths.

GROUND LEVEL

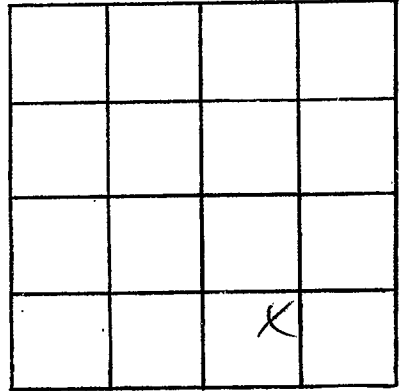

SECTION 11

Please indicate well location X.

ADDITIONAL INFORMATION

If more than one screen, show locations of each on sketch.