

LOWNDES

G-65

8-15-70

MISSISSIPPI
 BOARD OF WATER COMMISSIONERS
 416 North State Street
 Jackson, Mississippi 39201

CODED

WATER WELL DRILLERS LOG

8-15 1970 W. J. REEVES & SON LOWNDES
 date well completed firm name county well located

LANDOWNER: N. T. CHRISTIAN

description of formations encountered

from to

RT. 4

COLUMBUS

(mailing address)

WELL LOCATION:

sec. 34 T. 18 S. R. 18 E
 2 miles S. of COLUMBUS
 (distance) (direction) (nearest town)

WELL PURPOSE: HOME
 (home, irrigation, municipal, industrial)

WELL COMPLETION DATA:

- (1) diameter (inches) 4
- (2) total depth (feet) 177
- (3) static water level (feet) 25 below top of ground.
- (4) casing STEEL 41' (material) (depth)
 4" (size) if telescope see back.
- (5) screen NONE (length) (depth to top)
 (size) (material)
- (6) pump NONE (HP) (yield gpm)
 (type power)
- (7) electric log NO (yes or no)
 (organization running log)
- (8) how well bottom plugged OPEN

CLAY	0	9
SAND & GRAVEL	9	33
BLUE CLAY	33	94
" SAND	94	98
" CLAY	98	119
" SAND	119	126
" CLAY	126	141
" SAND	141	177

CODED


NOV 25 1970

MISS. BD. OF WATER COMMISSIONERS

DRILLERS REMARKS:

If well telescopes please sketch and show depths.

GROUND LEVEL

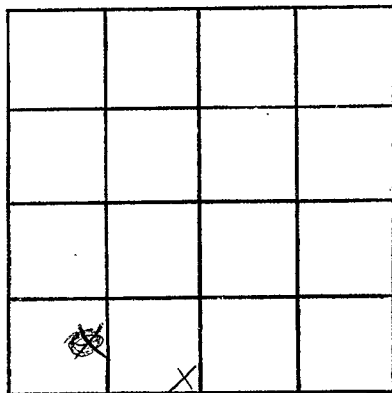

SECTION 34

Please indicate well location X.

ADDITIONAL INFORMATION

If more than one screen, show locations of each on sketch.