

LOWNDES

G 66

8-24-70

MISSISSIPPI
 BOARD OF WATER COMMISSIONERS
 416 North State Street
 Jackson, Mississippi 39201

CODED

WATER WELL DRILLERS LOG

8-24 1970 W.J. PREEVES & SON LOWNDES
 date well completed firm name county well located

LANDOWNER: PERMA-SEPTIC TANK CO.
 LEHARBURG RD.

description of formations encountered	from	to
CLAY	0	17
SAND & GRAVEL	17	29
BLUE CLAY + SAND	29	37
" CLAY	37	89
" SAND	89	93
" CLAY	93	113
" SAND	113	121
" CLAY	121	132
" SAND	132	153

COLUMBUS
 (mailing address)

WELL LOCATION:
 sec. 12 T 18 N R 18 E
 S W
 1 miles E of Columbus
 (distance) (direction) (nearest town)

WELL PURPOSE: INDUSTRIAL
 (home, irrigation, municipal, industrial)

- WELL COMPLETION DATA:
- (1) diameter (inches) 4
 - (2) total depth (feet) 153
 - (3) static water level (feet) 10 below above top of ground.
 - (4) casing STEEL 51 (material) (depth)
 4 (size) If telescope see back.
 - (5) screen NONE (length) (depth to top)
 (size) (material)
 - (6) pump 1 30 (HP) (yield gpm)
 ELECT (type power)
 - (7) electric log NO (yes or no)
 (organization running log)
 - (8) how well bottom plugged OPEN

CODED


NOV 25 1970

MISS. RD. OF WATER COMM.

DRILLERS REMARKS:

If well telescopes please sketch and show depths.

GROUND LEVEL

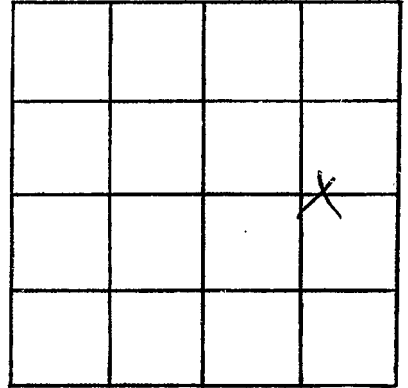

SECTION 12

Please indicate well location X.

ADDITIONAL INFORMATION

If more than one screen, show locations of each on sketch.