

LOWNDES
G-67
8-25-70

MISSISSIPPI
BOARD OF WATER COMMISSIONERS
416 North State Street
Jackson, Mississippi 39201

CODED

WATER WELL DRILLERS LOG

8-25 1970 W. J. REEVER & SON LOWNDES
date well completed firm name county well located

LANDOWNER: D. A. MOORE
LEHMBURG RD.
COLUMBUS
(mailing address)

WELL LOCATION:
sec. 12 T. 18 N. R. 18 E
S W
1 miles E of COLUMBUS
(distance) (direction) (nearest town)

WELL PURPOSE: HOME
(home, irrigation, municipal, industrial)

- WELL COMPLETION DATA:
- (1) diameter (inches) 4
 - (2) total depth (feet) 153
 - (3) static water level (feet) 12 below above top of ground.
 - (4) casing STEEL, 55
(material) (depth)
4 if telescope see back.
(size)
 - (5) screen NONE
(length) (depth to top)
(size) (material)
 - (6) pump NONE
(HP) (yield gpm)
(type power)
 - (7) electric log NO
(yes or no)
(organization running log)
 - (8) how well bottom plugged OPEN

description of formations encountered	from	to
CLAY	0	16
SAND & GRAVEL	16	30
BLUE CLAY + SAND	30	40
" CLAY	40	92
" SAND	92	95
" CLAY	95	111
" SAND	111	119
" CLAY	119	131
" SAND	131	139
" CLAY	139	146
" SAND	146	153

CODED


NOV 25 1970

MISS. BD. OF
WATER

DRILLERS REMARKS:

If well telescopes please sketch and show depths.

GROUND LEVEL

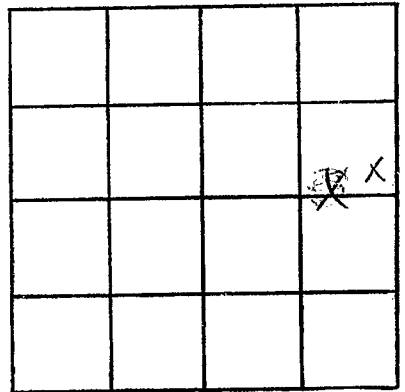

SECTION 12

Please indicate well location X.

ADDITIONAL INFORMATION

If more than one screen, show locations of each on sketch.