

LOWMEES
G 70
12-24-70

MISSISSIPPI
BOARD OF WATER COMMISSIONERS
416 North State Street
Jackson, Mississippi 39201

CODED

WATER WELL DRILLERS LOG

12-24 1970 COLUMBUS WELL DRILLING & DIGGING SER.
date well completed 420 JOLEWILD
COLUMBUS, MISSISSIPPI 39701

Lowmees
county well located

LANDOWNER: *Ralph Boykin*
Route 5, Box 315
Columbus, Miss
Plymouth Rd. (mailing address) 3273608

description of formations encountered	from	to
<i>Sand</i>	<i>0</i>	<i>8</i>
<i>Sand & gravel</i>	<i>8</i>	<i>18</i>
<i>Blue clay</i>	<i>18</i>	<i>130</i>
<i>Rock with some soil</i>	<i>130</i>	<i>170</i>
<i>Sandy streaks</i>	<i>170</i>	<i>190</i>

WELL LOCATION:
sec. *17* T. *18* N R. *18* W
1 1/2 miles NW of *Columbus*
(distance) (direction) (nearest town)

WELL PURPOSE: *None*
(home, irrigation, municipal, industrial)

- WELL COMPLETION DATA:
- (1) diameter (inches) *4"*
 - (2) total depth (feet) *190*
 - (3) static water level (feet) *8'* below top of ground.
 - (4) casing *24 1/4" Steel*
(material) (depth)
 If telescope see back.
(size)
 - (5) screen (length) (depth to top)
(size) (material)
 - (6) pump *None*
(HP) (yield gpm)
(type power)
 - (7) electric log *NO -*
(yes or no)
(organization running log)
 - (8) how well bottom plugged *OPEN*

CODED


JAN 25 1971

MISS. BD. OF
WATER COMMISSIONERS

DRILLERS REMARKS:

If well telescopes please sketch and show depths.

GROUND LEVEL

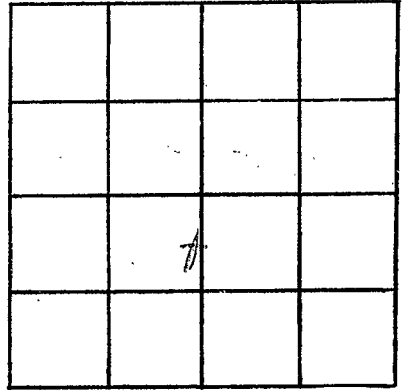

SECTION _____

Please indicate well location X.

ADDITIONAL INFORMATION

If more than one screen,
show locations of each on sketch.