

LOWNDES
G 71
1-19-71

MISSISSIPPI
BOARD OF WATER COMMISSIONERS
416 North State Street
Jackson, Mississippi 39201

CODED

WATER WELL DRILLERS LOG

1-19-71 19 date well completed
COLUMBUS WELL DRILLING & DIGGING SER. 420 IDEWILD
COLUMBUS MISSISSIPPI 39701 county well located *Lowndes*

LANDOWNER: *Charles Shepherd*
Sylvia
2606 6th Ave N.
Columbus, Miss
(mailing address)

description of formations encountered	from	to
<i>Gravel 3/4"</i>	<i>4</i>	<i>16</i>
<i>Blue clay</i>	<i>23</i>	<i>30</i>
<i>Sand, streaks clay</i>	<i>31</i>	<i>70</i>
<i>Solid clay</i>	<i>71</i>	<i>80</i>
<i>Sand</i>	<i>81</i>	<i>106</i>
<i>Streaks of Sand</i>	<i>106</i>	<i>130</i>
<i>Sand</i>	<i>130</i>	<i>150</i>

WELL LOCATION:
sec. *11* T. *18* N. R. *18* E
3 1/2 miles *E* of *COL*
(distance) (direction) (nearest town)

WELL PURPOSE: *Home*
(home, irrigation, municipal, industrial)

- WELL COMPLETION DATA:
- (1) diameter (inches) 4"
 - (2) total depth (feet) 150
 - (3) static water level (feet) 4' below top of ground.
 - (4) casing Steel 23'
(material) (depth)
(size) if telescope see back.
 - (5) screen _____
(length) (depth to top)
(size) (material)
 - (6) pump 3/4 12
(HP) (yield gpm)
220V AC
(type power)
 - (7) electric log No
(yes or no)
 - (organization running log)
 - (8) how well bottom plugged open

CODED


JAN 25 1971

MISS. BD. OF
WATER COMMISSIONERS

DRILLERS REMARKS:

If well telescopes please sketch and show depths.

GROUND LEVEL

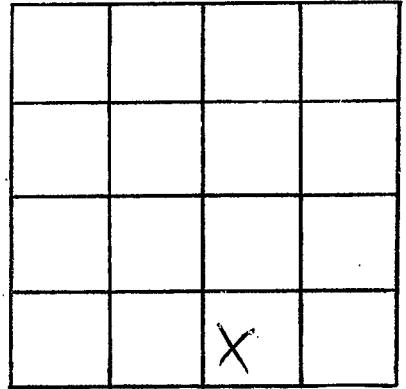

SECTION 11

Please indicate well location X.

ADDITIONAL INFORMATION

If more than one screen, show locations of each on sketch.