

# CODED

LOWNDES  
G-72  
7-27-71

MISSISSIPPI  
 BOARD OF WATER COMMISSIONERS  
 416 North State Street  
 Jackson, Mississippi 39201

# CODED

## WATER WELL DRILLERS LOG

JULY 27 1971 WATSON Co. LOWNDES  
 date well completed firm name county well located

LANDOWNER: COLUMBUSCOUNTRY CLUB
COLUMBUS, MISS.  
 (mailing address)

description of formations encountered

from to

SURFACE CLAY 0 16SAND 16 20PEA GRAVEL 20 27CLAY STREAKED WITH SAND 27 75

## WELL LOCATION:

 sec. 10 T. 18 S. R. 18 E.  
1 miles NE of COLUMBUS  
 (distance) (direction) (nearest town)

 WELL PURPOSE: IRRIGATION  
 (home, irrigation, municipal, industrial)
SHALEY CLAY WITH HARD STREAKS 75 177

## WELL COMPLETION DATA:

(1) diameter (inches) 8"(2) total depth (feet) 318' 7"(3) static water level (feet) 36 below top of ground.(4) casing STEEL, 285' 4"  
 (material) (depth)

(size) if telescope see back.

(5) screen 33' 3", 280' 10"  
 (length) (depth to top)6" I.D., STAINLESS STEEL  
 (size) (material)(6) pump 40 300 GPM  
 (HP) (yield gpm)ELEC.  
 (type power)(7) electric log No  
 (yes or no)

(organization running log)

(8) how well bottom plugged B.P.  
VALVEHARD ROCK 177 178SHALE 178 181ROCK 181 182SHALE 182 185ROCK 185 186SHALE, SAND STRS. 186 235HARD CLAY 235 285MED. SAND 285 319FINE SAND 319 339

AUG 23 1971


MISS. BD. OF  
WATER COMM.

DRILLERS REMARKS:



If well telescopes please sketch and show depths.

GROUND LEVEL

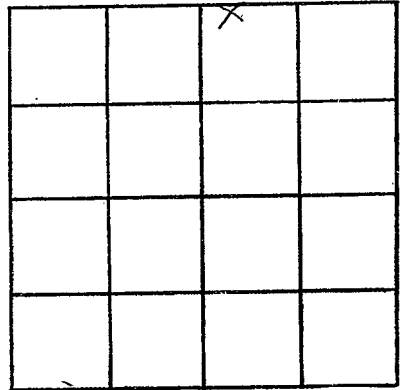

SECTION 10

Please indicate well location X.

ADDITIONAL INFORMATION

If more than one screen, show locations of each on sketch.