

**LOWNDES**

MISSISSIPPI BOARD OF WATER COMMISSIONERS

328400

G 74

**WATER WELL DRILLERS LOG**

*Not Gravel pack*

7-24-64

Date: 7-24-, 1964, Driller: Layne-Central Co. County: Lowndes

(Name)

(1) Owner of Land: Beneke Corporation

(Name)

Columbus, Mississippi

(Address)

(2) Location: 1/4, 1/4, Sec. T R

           miles, of             
(distance) (direction) (Nearest Town)

(3) Topography:             
(Hilly) (Flat) (Level)

(4) Purpose of Well: Industrial  
(Domestic Irrigation  
Municipal, Industrial, Other)

Description & Color of Materials Sand, Clay, Red Clay, Shell, etc.	Thick- ness Feet	Depth Feet
red sandy clay	5	5
sand and gravel	20	25
hard blue clay	115	140
hard rock	1	141
hard shale	9	150
shale-sand stks	16	166
hard shale	148	314
hard gummy clay	98	412
sand	5	417
hard shale	36	453
hard pack sand red	71	524

Information upon completion of well:

(1) Diameter 10 inches.

(2) Total Depth 527 feet.

(3) Water Level 2' feet below top of ground.

(4) Cased to 473', Size 10"

(5) Screen: Size 8", Length 50'

*400 gpm. = 40.*


(6) Were any formations sealed against pollution?

X yes,            no.

If YES depth of formation 473'

Why            required

Drillers Remarks:           

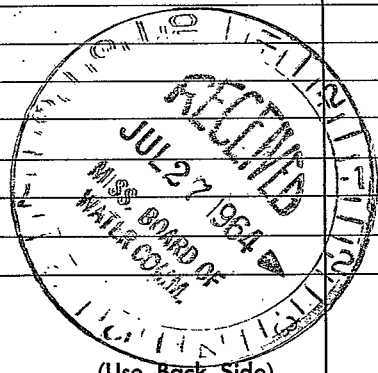

(Use Back Side)

Well No.

(X)