

In front of Blount

#2

328-4000


LOWNDES
G 75
6-67

MISSISSIPPI *Seward Ave*
 BOARD OF WATER COMMISSIONERS
 416 North State Street
 Jackson, Mississippi 39201

WATER WELL DRILLERS LOG

6-30 1967 Layne-Central Co. LOWNDES
 date well completed firm name county well located

LANDOWNER: <u>BENEKE Corp.</u>	description of formations encountered	from	to
<p><u>Columbus, Miss.</u> (mailing address)</p> <p>WELL LOCATION: NE <u>15</u> T <u>18</u> N R <u>18</u> E (distance) miles _____ of _____ (direction) (nearest town)</p> <p>WELL PURPOSE: <u>Industrial</u> (home, irrigation, municipal, industrial)</p> <p>WELL COMPLETION DATA:</p> <p>(1) diameter (inches) <u>12"</u></p> <p>(2) total depth (feet) <u>524'</u></p> <p>(3) static water level (feet) <u>24</u> below above top of ground.</p> <p>(4) casing <u>steel</u>, <u>468</u>, (material) (depth) <u>12"</u> if telescope see back. (size)</p> <p>(5) screen <u>50'</u>, <u>472'</u> (length) (depth to top) <u>10"</u>, <u>Stainless Steel</u> (size) (material)</p> <p>(6) pump <u>25</u> <u>600</u> (HP) (yield gpm) <u>_____</u> (type power)</p> <p>(7) electric log <u>NO</u> (yes or no) <u>_____</u> (organization running log)</p> <p>(8) how well bottom plugged _____</p> <p>DRILLERS REMARKS: <u>Pump not installed as of this date - No test RUN</u></p>	<u>Fill</u>	<u>0</u>	<u>2</u>
	<u>Blue Clay</u>	<u>2</u>	<u>8</u>
	<u>SAND AND GRAVEL</u>	<u>8</u>	<u>24</u>
	<u>HARD BLUE CLAY</u>	<u>24</u>	<u>140</u>
	<u>SANDY SHALE</u>	<u>140</u>	<u>163</u>
	<u>Rock</u>	<u>163</u>	<u>164</u>
	<u>HARD SHALE AND ROCK STKS</u>	<u>164</u>	<u>257</u>
	<u>HARD SHALE AND SAND STKS</u>	<u>257</u>	<u>270</u>
	<u>HARD SHALE</u>	<u>270</u>	<u>460</u>
	<u>SAND AND STKS, SHALE</u>	<u>460</u>	<u>480</u>
	<u>SAND</u>	<u>480</u>	<u>510</u>
	<u>Shale BREAK</u>	<u>510</u>	<u>517</u>
	<u>SAND AND PEA GRAVEL</u>	<u>512</u>	<u>520</u>
	<u>Shale</u>	<u>520</u>	<u>524</u>

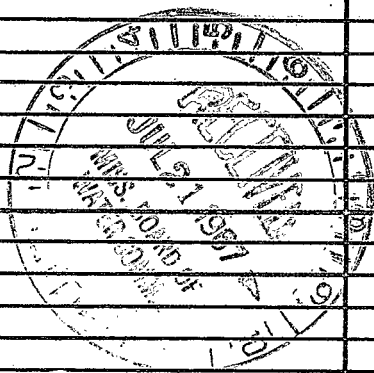

⊗

500-550 ft

2 of holes
both

If well telescopes please
sketch and show depths.

GROUND LEVEL

NE

	X		

SECTION 15

Please indicate well location X.

ADDITIONAL INFORMATION

If more than one screen,
show locations of each on sketch.