

Continued from page 1

MISSISSIPPI
BOARD OF WATER COMMISSIONERS
416 North State Street
Jackson, Mississippi 39201
WATER WELL DRILLERS LOG

Landes Co

477

date well completed 19

firm name

county well located

LANDOWNER: Ralph Williams

Airline Drfg Co.

(mailing address)

description of formations encountered

from

to

Sand & gravel

445 475

Red Clay

475 490

Sand & gravel

490 494

WELL LOCATION:

sec. T N R E
S W

miles of (distance) (direction) (nearest town)

WELL PURPOSE:

(home, irrigation, municipal, industrial)

WELL COMPLETION DATA:

- (1) diameter (inches) _____
- (2) total depth (feet) _____
- (3) static water level (feet) _____ below
top of ground. above
- (4) casing _____ (material) _____ (depth) _____
_____ if telescope see back.
(size)
- (5) screen _____ (length) _____ (depth to top) _____
_____ (size) _____ (material)
- (6) pump _____ (HP) _____ (yield gpm) _____
_____ (type power)
- (7) electric log _____ (yes or no) _____
_____ (organization running log)
- (8) how well bottom plugged _____

DRILLERS REMARKS:


APR 15 1955
MISSISSIPPI
WATER CO.

May 69 off 82. at Camp 0 1/2

(X)

If well telescopes please sketch and show depths.

GROUND LEVEL

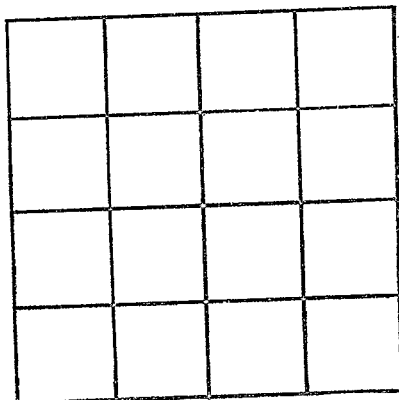

SECTION _____

Please indicate well location X.

ADDITIONAL INFORMATION

If more than one screen, show locations of each on sketch.