

LOWNDES MISSISSIPPI BOARD OF WATER COMMISSIONERS

G78

4-11-61

WATER WELL DRILLERS LOG

CODED

G320

Date: 4-11, 1961, Driller: W.J. REEVES & SON County LOWNDES

11250 12991

(Name)

(1) Owner of Land: L.D. WHARTON (Name)

LEHMBERG RD. COLUMBUS (Address)

(2) Location: SW 1/4, Sec. 13, T. 8 N., R. 2 W., E. 2

2 miles EAST, of COLUMBUS, (distance) (direction) (Nearest Town)

(3) Topography: FLAT (Hilly) (Flat) (Level)

(4) Purpose of Well: DOMESTIC (Domestic Irrigation Municipal, Industrial, Other)

Description & Color of Materials Sand, Clay, Red Clay, Shell, etc.

Thickness Feet

Depth Feet

CLAY	9	0
SAND & GRAVEL	21	9
BLUE CLAY	38	30
SAND	22	68

CODED

Information upon completion of well:

(1) Diameter 4 inches.

(2) Total Depth 90 feet.

(3) Water Level 5 feet below top of ground.

(4) Cased to 34', Size 4"

(5) Screen: Size 1, Length


(6) Were any formations sealed against pollution?

yes, no.

If YES depth of formation

Why

Drillers Remarks:

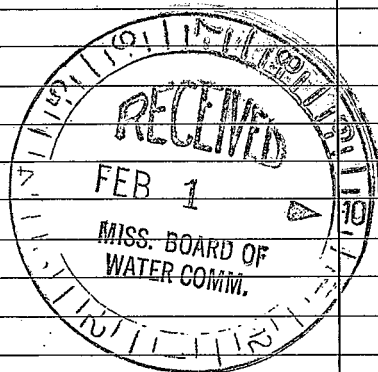

(Use Back Side)

Well No.

