

G81

2310

10-4-60

WATER WELL DRILLERS LOG

CODED

Date: 10-4, 1960, Driller: W.J. REEVES & SON County LOWNDES

12554

(Name)

(1) Owner of Land: BROOKS FIELDS
(Name) SILVAN

COLUMBUS MISS.
(Address)

(2) Location: SE 1/4, 1/4, Section 12, T. 5 R. 10 W.

1 miles E, of COLUMBUS,
(distance) (direction) (Nearest Town)

(3) Topography: FLAT
(Hilly) (Flat) (Level)

(4) Purpose of Well: DOMESTIC
(Domestic Irrigation
Municipal, Industrial, Other)

Information upon completion of well:

- (1) Diameter 4 inches.
- (2) Total Depth 90 feet.
- (3) Water Level 6 feet below top of ground.
- (4) Cased to 25' 8", Size 4"
- (5) Screen: Size _____, Length _____.
- (6) Were any formations sealed against pollution?
_____ yes, _____ no.

If YES depth of formation _____

Why _____

Drillers Remarks: _____


Description & Color of Materials
Sand, Clay, Red Clay, Shell, etc.

Thick-
ness
Feet

Depth
Feet

CLAY	8	0
SAND & GRAVEL	15	8
BLUE CLAY	34	23
BLUE SAND	33	57

CODED

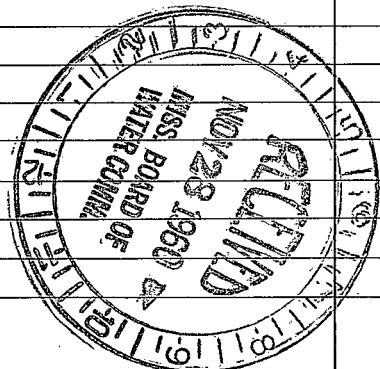

(Use Back Side)

Well No.

Handwritten text, possibly a list or notes, with some faint markings and a small grid-like structure on the left side.

Main body of handwritten text, appearing to be a list or series of notes, with some faint markings and a small grid-like structure on the left side.