

G83

7-18-62

WATER WELL DRILLERS LOG

CODED

Date: 7-18, 1962, Driller: J.C. REEVES County LOWNDES

13640

(Name)

(1) Owner of Land: E.O. ESTES (Name)

Columbus, Miss

H.W. 695 3286739 (Address)

(2) Location: SE SE 1/4, NW 1/4, Sec. 35 T18R14E

2 miles S.E. of Columbus (distance) (direction) (Nearest Town)

(3) Topography: LEVEL (Hilly) (Flat) (Level)

(4) Purpose of Well: DOMESTIC (Domestic Irrigation Municipal, Industrial, Other)

Information upon completion of well:

(1) Diameter: 4 inches.

(2) Total Depth: 156 feet.

(3) Water Level: 8' feet below top of ground.

(4) Cased to 21' 9", Size 4"

(5) Screen: Size, Length

(6) Were any formations sealed against pollution? yes, no.

If YES depth of formation

Why

Drillers Remarks:


Description & Color of Materials Sand, Clay, Red Clay, Shell, etc.

Thickness Feet

Depth Feet

CLAY	8	0
SAND & GRAVEL	11	8
BIVE CLAY	53	19
" SAND	9	72
" CLAY	31	81
" SAND	14	112
" CLAY	13	126
" SAND	17	139

CODED

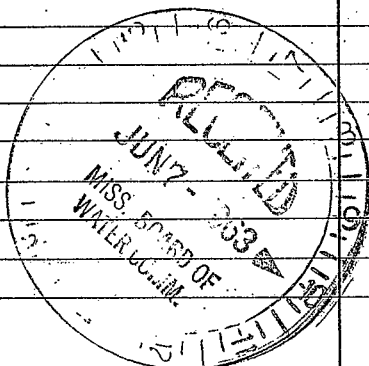

(Use Back Side)

Well No.

