

LOWNDES

MISSISSIPPI BOARD OF WATER COMMISSIONERS

Q 685

5-25-61

WATER WELL DRILLERS LOG

CODED

Date: 5-25, 1961, Driller: J.C. REEVES County: LOWNDES

Mrs. Ford (Waverly Rd)

12590

(Name)

(1) Owner of Land: MRS. FORD R.C. JONES

(Name)

COLUMBUS MISS

(Address)

(2) Location: SE NW SW 8 1/4, 1/4, Sec. 18 T16 R16W

2 miles NORTH of Columbus (distance), (direction), (Nearest Town)

(3) Topography: FLAT (Hilly), (Flat), (Level)

(4) Purpose of Well: DOM (Domestic Irrigation, Municipal, Industrial, Other)

Description & Color of Materials Sand, Clay, Red Clay, Shell, etc.

Thick-ness Feet

Depth Feet

CLAY	11	0
SAND & GRAVEL	37	11
BLUE CLAY	67	48
" SAND	18	115
" CLAY	16	133
" SAND	48	149

Information upon completion of well:

CODED


- (1) Diameter 4 inches.
- (2) Total Depth 197 feet.
- (3) Water Level 15 feet below top of ground.
- (4) Cased to 51', Size 4"
- (5) Screen: Size \_\_\_\_\_, Length \_\_\_\_\_
- (6) Were any formations sealed against pollution?

yes, no.

If YES depth of formation \_\_\_\_\_

Why \_\_\_\_\_

Drillers Remarks: \_\_\_\_\_

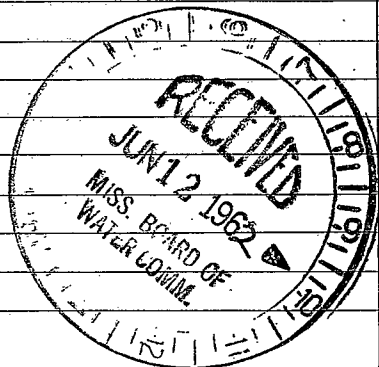

(Use Back Side)

Well No.

