

LOWNDES

MISSISSIPPI BOARD OF WATER COMMISSIONERS

CG86

8-63

WATER WELL DRILLERS LOG

CODED

Date: Aug, 1963, Driller: W. B. Clardy County Louises

10171 13083

(Name)

(1) Owner of Land: Thomas A. Moore
 328 7200 (Name)
Waverly Rd. (Address)
 NW SW SE 18 18 W
 (2) Location: 1/4, 1/4, Sec. 18 18 W
2 miles NW of Colo.
 (distance) (direction) (Nearest Town)
 (3) Topography: Level
 (Hilly) (Flat) (Level)
 (4) Purpose of Well: Domestic
 (Domestic Irrigation
 Municipal, Industrial, Other)

Description & Color of Materials Sand, Clay, Red Clay, Shell, etc.	Thick- ness Feet	Depth Feet
<u>Sand + gravel</u>	<u>5'</u>	<u>24'</u>
<u>Sand</u>	<u>60'</u>	<u>63'</u>
<u>Rock</u>	<u>130'</u>	
<u>Sand</u>	<u>170'</u>	<u>190'</u>


Information upon completion of well:

(1) Diameter 4 inches.
 (2) Total Depth 190 feet.
 (3) Water Level 16 feet below top of ground.
 (4) Cased to 31, Size 4"
 (5) Screen: Size _____, Length _____
 (6) Were any formations sealed against pollution?
 _____ yes, _____ no.

CODED

If YES depth of formation _____
 Why _____

Drillers Remarks: _____

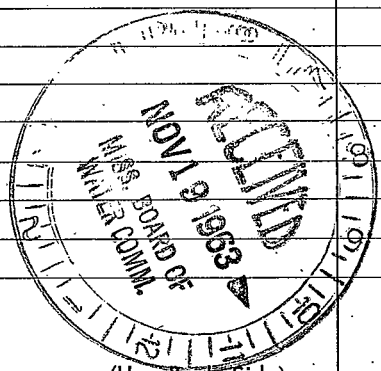

(Use Back Side)

Well No.

