

G87

4-5-61

WATER WELL DRILLERS LOG

CODED

G 319

Date: 4-5, 1961, Driller: W. J. REEVES & SON County: LOWNDES

16583

(Name)

(1) Owner of Land: C. L. McCALDER (Name)

COLUMBUS, MISS. HW 45 N 3287103 (Address) SE NE NW 1/4, 1/4, Sec. 29 T19N R18E

1 miles WEST of COLUMBUS (distance) (direction) (Nearest Town)

(3) Topography: FLAT (Hilly) (Flat) (Level)

(4) Purpose of Well: CATTLE (Domestic Irrigation Municipal, Industrial, Other)

Description & Color of Materials Sand, Clay, Red Clay, Shell, etc.

Thick-ness Feet

Depth Feet

CLAY	8	0
SAND & GRAVEL	28	8
BLUE CLAY	27	36
" SAND	8	63
" CLAY	46	71
" SAND	12	117
" CLAY	7	129
" SAND	19	136

Information upon completion of well:

(1) Diameter: 4 inches.

(2) Total Depth: 155 feet.

(3) Water Level: 12 feet below top of ground.

(4) Cased to: 39'5", Size: 4"

(5) Screen: Size: —, Length: —


(6) Were any formations sealed against pollution? — yes, — no.

If YES depth of formation: —

Why: —

Drillers Remarks: —

CODED

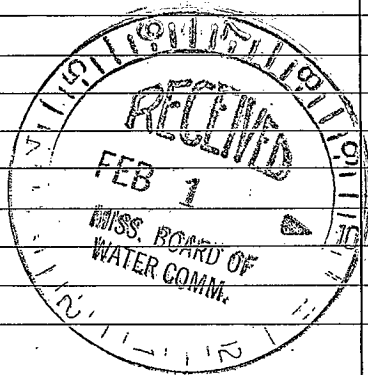

(Use Back Side)

Well No.

