

LOWNDES  
60690  
7-23-60  
Date: July 23, 1960

WATER WELL DRILLERS **CODED** G301

Date: July 23, 1960, Driller: W. B. Clardy County Loudeau  
(Name)


TRAVELERS MOTEL  
 (1) Owner of Land: C. G. Campbell  
 (Name)  
Campbell Motel Hwy 82W  
 #W455 3284710 (Address)  
 (2) Location: NE 1/4, NE 1/4 Sec. 30 T. 19N R. 18E  
1/2 miles West of Columbus  
 (distance) (direction) (Nearest Town)  
 (3) Topography: X  
 (Hilly) (Flat) (Level)  
 (4) Purpose of Well: Industrial  
 (Domestic Irrigation  
 Municipal, Industrial, Other)

Description & Color of Materials Sand, Clay, Red Clay, Shell, etc.	Thick- ness Feet	Depth Feet
Sand + Gravel	18'	22'
Blue Clay	22'	38'
Rock	38'	
Blue Clay and shell		
Rock	38'	60'
Sand	60'	64'
Clay	64'	160'
Sand	160'	183'

Information upon completion of well:

(1) Diameter 4 inches.  
 (2) Total Depth 183 feet.  
 (3) Water Level 10 feet below top of ground.  
 (4) Cased to 41', Size 4"  
 (5) Screen: Size \_\_\_\_\_, Length \_\_\_\_\_  
 (6) Were any formations sealed against pollution?  
 \_\_\_\_\_ yes, \_\_\_\_\_ no.

**CODED**

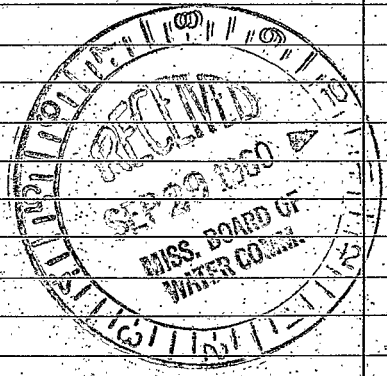

If YES depth of formation \_\_\_\_\_  
 Why \_\_\_\_\_  
 Drillers Remarks: \_\_\_\_\_

(Use Back Side)

Well No. G301

