

LOWNDES

G91

MISSISSIPPI BOARD OF WATER COMMISSIONERS

5-28-66

WATER WELL DRILLERS LOG

CODED

Date: 5-28, 1966, Driller: J. C. REEVES County LOWNDES

(When well drilled) 12139, 40

(Name)

(Where well is located)

(1) Owner of Land: FRED BEARD (Name)

2512 BLUECUTT RD, COLUMBUS (Address)

(2) Location: SW SE NE 1/4, 1/4, Sec. 4 T18 R18 W (Location)

1 miles N of COLUMBUS (distance) (direction) (Nearest Town)

(3) Topography: HILLY (Hilly) (Flat) (Level)

(4) Purpose of Well: DOMESTIC (Domestic Irrigation Municipal, Industrial, Other)

| Description & Color of Materials Sand, Clay, Red Clay, Shell, etc. | Thick- ness Feet | Depth Feet |
|---|------------------------|---------------|
| RED SAND | 21 | |
| BLUE SANDY CLAY | 41 | 21 |
| " SAND (SOFT) | 18 | 62 |
| " SANDY CLAY | 44 | 80 |
| " CLAY | 21 | 124 |
| " SAND | 17 | 145 |
| " CLAY | 23 | 162 |
| " SAND | 13 | 185 |
| " CLAY | 67 | 198 |

Information upon completion of well:

(1) Diameter 4 inches.

(2) Total Depth 265 feet.

(3) Water Level 63 feet below top of ground.

(4) Cased to 132 1/2', Size 4"

(5) Screen: Size —, Length —

(6) Were any formations sealed against pollution?

yes, no.

If YES depth of formation

Why


Drillers Remarks:

Yield in gpm: 20 AIR

Size pump: 3/4 H.P. SUB-106PM

Type power: ELECTRIC

CODED

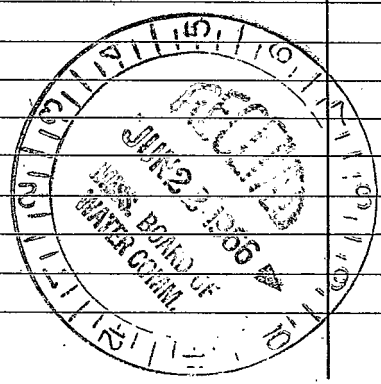

[The page contains extremely faint, illegible text, likely bleed-through from the reverse side of the document. The text is arranged in several columns and paragraphs, but the characters are too light to be transcribed accurately.]