

G92  
10-63

WATER WELL DRILLERS LOG **CODED**

Date: Oct, 1963, Driller: W B. Cloudy County Lauderdale

B515

(Name)

SON-IN-LAW  
 (1) Owner of Land: Nelson Myers  
 (Name)  
 HW 12  
 3284463  
 (Address)  
 (2) Location: SE SW 3 185 180  
1/4, 1/4, Sec. 5 T4R10  
1/4 miles N of Colo.  
 (distance) (direction) (Nearest Town)  
 (3) Topography: Hilly  
 (Hilly) (Flat) (Level)  
 (4) Purpose of Well: Domestic  
 (Domestic Irrigation  
 Municipal, Industrial, Other)


Description & Color of Materials Sand, Clay, Red Clay, Shell, etc.	Thick-ness Feet	Depth Feet
<u>Blue Clay</u>		<u>50'</u>
<u>Sand</u>	<u>135-</u>	<u>138'</u>
<u>Sand</u>	<u>164'-</u>	<u>170'</u>
<u>Rock</u>	<u>180'</u>	
<u>Rock</u>	<u>184'</u>	
<u>Sand</u>	<u>211'-</u>	<u>215'</u>
<u>Rock</u>	<u>215'</u>	
<u>Rock</u>	<u>217'</u>	
<u>Sand</u>	<u>236'-</u>	<u>250'</u>
<u>Sand</u>	<u>260'-</u>	<u>270'</u>
<u>Sand</u>	<u>312'-</u>	<u>320'</u>

Information upon completion of well:

(1) Diameter 4 inches.  
 (2) Total Depth 331 feet.  
 (3) Water Level \_\_\_\_\_ feet below top of ground.  
 (4) Cased to 126', Size 4"  
 (5) Screen: Size 4", Length 20'  
 (6) Were any formations sealed against pollution?  
 \_\_\_\_\_ yes, \_\_\_\_\_ no.

**CODED**

If YES depth of formation \_\_\_\_\_  
 Why \_\_\_\_\_  
 Drillers Remarks: \_\_\_\_\_

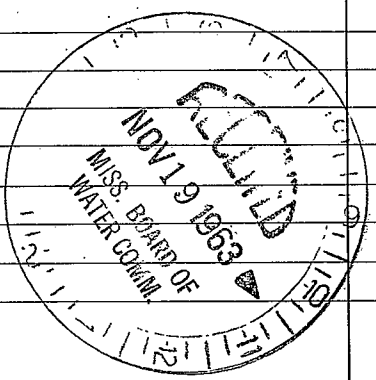

(Use Back Side)

Well No.

