

Ptn 10/17/69

Recd 11/3/69

LOWNDES

LOWDES

Q 1 G93

8-1-69

MISSISSIPPI
 BOARD OF WATER COMMISSIONERS
 416 North State Street
 Jackson, Mississippi 39201

CODED

WATER WELL DRILLERS LOG

August 1 1969 Carloss Well Supply Co Lowndes
 date well completed firm name county well located

LANDOWNER:

COLUMBUS COUNTRY CLUB

Columbus, Mississippi
 (mailing address)

WELL LOCATION:

3 sec ~~B~~ ~~D~~ ~~X~~ T ~~D~~ ~~X~~ S R 18 E
 2 miles NE of Columbus
 (distance) (direction) (nearest town)

WELL PURPOSE: Irrigation
 (home, irrigation, municipal, industrial)

WELL COMPLETION DATA:

- (1) diameter (inches) 8
- (2) total depth (feet) 370'
- (3) static water level (feet) 81 below top of ground.
- (4) casing Steel 330 (material), (depth)
- _____ If telescope see back. (size)
- (5) screen 40 339 (length), (depth to top)
- 6" S.S. (size), (material)
- (6) pump 30 300 (HP), (yield gpm)
- Electric (type power)
- (7) electric log No (yes or no)
- _____ (organization running log)
- (8) how well bottom plugged BP Valve

description of formations encountered

from to

Top soil & clay	0	20
Hard Blue clay	20	43
Sand & clay	43	61
Clay	61	95
Rock	95	97
clay with sand streaks	97	169
Rock	169	170
Rock streak shale	170	221
Hard Blue shale	221	265
Shale streak sand	265	330
Med WB sand	330	379
Shale	379	432
Sand & Clay Streaks	432	474

CODED

OCT 16 1969


MISS. BD. OF WATER COMM.

DRILLERS REMARKS:

(A)

If well telescopes please sketch and show depths.

GROUND LEVEL

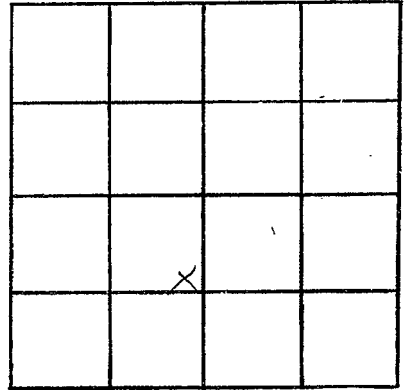

SECTION 3

Please indicate well location X.

ADDITIONAL INFORMATION

If more than one screen, show locations of each on sketch.