

G94
8-63

WATER WELL DRILLERS LOG

CODED

Date: Aug, 1963, Driller: W B Clardy County Lounnes
(Name)

(1) Owner of Land	Description & Color of Materials Sand, Clay, Red Clay, Shell, etc.	Thick- ness Feet	Depth Feet
<u>Davis Lumber Co.</u> <small>(Name)</small> <u>Hw 12</u> <u>Columbus, Miss.</u> <small>(Address)</small>	<u>Sand + gravel + blue clay</u> <u>down to 60'</u>		
<u>NW NW NE</u> <small>(Address)</small> (2) Location: <u>1/4</u> , <u>1/4</u> , Sec. <u>10</u> T <u>18</u> S R <u>18</u> W	<u>Sand</u> <u>60' - 64'</u> <u>Blue Clay</u>		
_____ miles _____ of _____ <small>(distance) (direction) (Nearest Town)</small>	<u>Sand</u> <u>150' - 170'</u>		
(3) Topography: <u>Level</u> <small>(Hilly) (Flat) (Level)</small>			
(4) Purpose of Well: <u>Industrial</u> <small>(Domestic Irrigation Municipal, Industrial, Other)</small>			

Information upon completion of well:


- (1) Diameter 4 inches.
- (2) Total Depth 170 feet.
- (3) Water level 14 feet below top of ground.
- (4) Cased to 42, Size _____.
- (5) Screen: Size _____, Length _____.
- (6) Were any formations sealed against pollution?
_____ yes, _____ no.

If YES depth of formation _____

Why _____

Drillers Remarks: _____

CODED

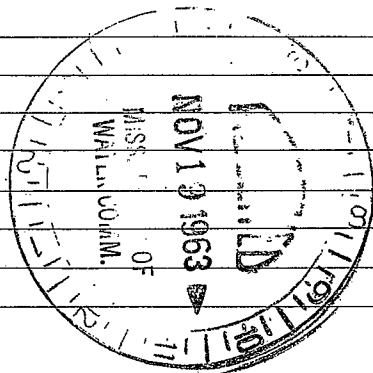

(Use Back Side)

Well No.

...the ...

...the ...

