

LOWNDES

967

MISSISSIPPI BOARD OF WATER COMMISSIONERS

12-27-65

WATER WELL DRILLERS LOG

CODED

Date: 12-27, 1965, Driller: J. C. REEVES County LOWNDES

(When well drilled) 967 10408

(Name)

(Where well is located)

(1) Owner of Land: BILLY HODGES J. C. DAVIS (Name)

STAR RT., COLUMBUS (Address)

(2) Location: W 1/2 SE NW COUNTRY CLUB HILLS SP 1/4, 1/4, Sec. 15 T 7 R 10 W

4 miles E of COLUMBUS (distance) (direction) (Nearest Town)

(3) Topography: HILLY (Hilly) (Flat) (Level)

(4) Purpose of Well: DOMESTIC (Domestic Irrigation Municipal, Industrial, Other)

Description & Color of Materials Sand, Clay, Red Clay, Shell, etc.	Thick- ness Feet	Depth Feet
RED CLAY	17	
" SAND	64	17
BLUE CLAY	33	81
" SAND	27	114
" CLAY	20	121
" SAND	6	141
" CLAY	22	147
" SAND	4	169
" CLAY	7	173
" SAND	16	180
" CLAY	4	196

Information upon completion of well:

(1) Diameter 4 inches.

(2) Total Depth 300 feet.

(3) Water Level 48 feet below top of ground.

(4) Cased to 84 1/2, Size 4"

(5) Screen: Size, Length

(6) Were any formations sealed against pollution?

yes, no.

If YES depth of formation

Why


Drillers Remarks:

Yield in gpm: 20 GPM - AIR

Size pump: NOT FURNISHED

Type power:

CODED

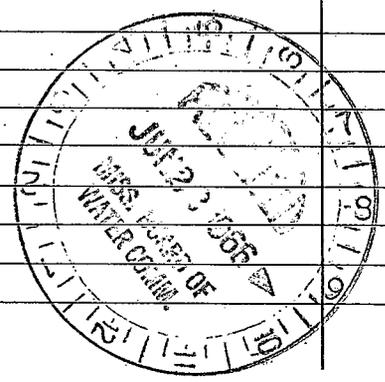

.....

.....

