

G100  
6-63

WATER WELL DRILLERS LOG

**CODED**

Date: June, 1963, Driller: Ed. B. Clardy County Lownes  
(Name)

(1) Owner of Land: <u>Ervin Shelton</u> (Name)	Description & Color of Materials Sand, Clay, Red Clay, Shell, etc.	Thick- ness Feet	Depth Feet
<u>Warpath Rd.</u> (Address)	<u>Gravel + Sand</u>	<u>8'</u>	<u>22'</u>
(2) Location: <u>SESE</u> $\frac{1}{4}$ , <u>12</u> $\frac{1}{4}$ Sec. <u>12</u> T <u>8</u> R <u>10</u> W	<u>Sand</u>	<u>60'</u>	<u>65'</u>
<u>2</u> miles <u>E</u> of <u>Colo.</u> (distance) (direction) (Nearest Town)	<u>Blue Clay</u>	<u>65'</u>	<u>120'</u>
(3) Topography: <u>Level</u> (Hilly) (Flat) (Level)	<u>Sand</u>	<u>120'</u>	<u>122'</u>
(4) Purpose of Well: <u>Domestic</u> (Domestic Irrigation Municipal, Industrial, Other)	<u>Blue Clay</u>	<u>122'</u>	<u>140'</u>
	<u>Sand</u>	<u>140'</u>	<u>150'</u>

Information upon completion of well:


- (1) Diameter 4 inches.
- (2) Total Depth 150 feet.
- (3) Water Level 10 feet below top of ground.
- (4) Cased to 44', Size 4"
- (5) Screen: Size \_\_\_\_\_, Length \_\_\_\_\_
- (6) Were any formations sealed against pollution?  
\_\_\_\_\_ yes, \_\_\_\_\_ no.

If YES depth of formation \_\_\_\_\_

Why \_\_\_\_\_

Drillers Remarks: \_\_\_\_\_

**CODED**

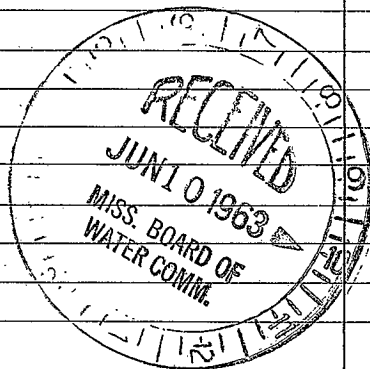

(Use Back Side)

Well No.

[The page contains extremely faint and illegible text, likely bleed-through from the reverse side of the document. No specific words or phrases can be discerned.]