

G101

10-25-61

WATER WELL DRILLERS LOG

CODED

Date: Oct 25, 1961, Driller: W. B. Cloudy County Lowndes

913 DENWA DR

13663

(Name)

(1) Owner of Land: <sup>changed</sup> B. G. Savage  
(Name)  
Waypath Rd  
(Address)

(2) Location: E 1/2 SE 1/4 SW 1/4, Sec. 12, T8R6W  
2 miles S of Cape, (direction) (Nearest Town)

(3) Topography: Flat  
(Hilly) (Flat) (Level)

(4) Purpose of Well: Domestic  
(Domestic Irrigation  
Municipal, Industrial, Other)

Description & Color of Materials Sand, Clay, Red Clay, Shell, etc.	Thick- ness Feet	Depth Feet
Gravel & Sand	10'-20'	
Blue Clay	20'-90'	
Sand	90'-100'	
Blue Clay	100'-130'	
Sand	130'-140'	

Information upon completion of well:

(1) Diameter 4 inches.

(2) Total Depth 145 feet.

(3) Water Level 8 feet below top of ground.

(4) Cased to 30, Size 4"

(5) Screen: Size, Length

(6) Were any formations sealed against pollution?


yes, no.

If YES depth of formation

Why

Drillers Remarks:

CODED

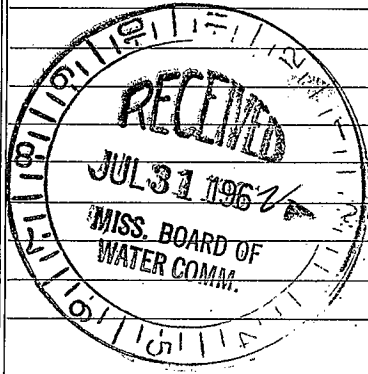

(Use Back Side)

Well No.

