

LOWNDES

06102

MISSISSIPPI BOARD OF WATER COMMISSIONERS

5-26-66

WATER WELL DRILLERS LOG

CODED

Date: 5-26, 1966, Driller: J. C. REEVES County LOWNDES

107 MASON (When well drilled)

(Name)

(Where well is located)

CP LAVOIE (1) Owner of Land: J. C. DAVIS (Name)

STAR RT. COLUMBUS (Address) SID 1218518W

(2) Location: MASONIC SW SW 1/4, Sec. 35-17R18N

1 miles E of COLUMBUS (distance) (direction) (Nearest Town)

(3) Topography: FLAT (Hilly) (Flat) (Level)

(4) Purpose of Well: DOMESTIC (Domestic Irrigation Municipal, Industrial, Other)

Description & Color of Materials Sand, Clay, Red Clay, Shell, etc.	Thick- ness Feet	Depth Feet
SOIL	1	
RED CLAY	12	1
RED SAND	4	13
SAND & GRAVEL	7	17
BLUE CLAY	4	21
BLUE SAND	3	28
" CLAY	26	31
" SAND	33	57

Information upon completion of well:

(1) Diameter 4 inches.

(2) Total Depth 90 feet.

(3) Water Level 51 feet below top of ground.

(4) Cased to 33', Size 4"

(5) Screen: Size —, Length —

(6) Were any formations sealed against pollution? yes, no.

If YES depth of formation

Why


Drillers Remarks:

Yield in gpm: 20 - AIR

Size pump: NOT FURNISHED

Type power:

CODED

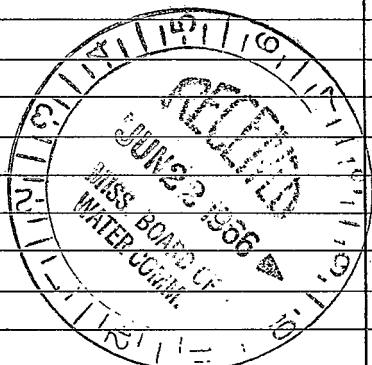

[The page contains extremely faint and illegible text, likely bleed-through from the reverse side of the document. No specific content can be transcribed.]