

LOWNDES MISSISSIPPI BOARD OF WATER COMMISSIONERS

RG-104

3-66

WATER WELL DRILLERS LOG

CODED

Date: March, 1966, Driller: W. B. Clardy County Lowndes
 (Name)
16654-57

- (1) Owner of Land: Fred Haley
 (Name)
Hwy. 82 West
 (Address)
- (2) Location: SW NE NE
 $\frac{1}{4}$, $\frac{1}{4}$, Sec. 30 T19N R18E
1 miles W of Columbus
 (distance) (direction) (Nearest Town)
- (3) Topography: level
 (Hilly) (Flat) (Level)
- (4) Purpose of Well: Domestic
 (Domestic Irrigation
 Municipal, Industrial, Other)

Description & Color of Materials Sand, Clay, Red Clay, Shell, etc.	Thick- ness Feet	Depth Feet
<u>Sand + Gravel</u>	<u>10'</u>	<u>20'</u>
<u>Blue sandy clay</u>	<u>30'</u>	<u>40'</u>
<u>Blue rock</u>	<u>40'</u>	<u>50'</u>
<u>3' sand</u>		
<u>Clay</u>	<u>50'</u>	<u>100'</u>
<u>Sand</u>	<u>100'</u>	<u>105'</u>
<u>Clay</u>	<u>105'</u>	<u>160'</u>
<u>Sandy Shale</u>	<u>160'</u>	<u>170'</u>


Information upon completion of well:

- (1) Diameter 4 inches.
- (2) Total Depth 170 feet.
- (3) Water level 14 feet below top of ground.
- (4) Cased to 42, Size 4"
- (5) Screen: Size _____, Length _____.
- (6) Were any formations sealed against pollution?
 _____ yes, _____ no.

If YES depth of formation _____
 Why _____

Drillers Remarks: _____

CODED

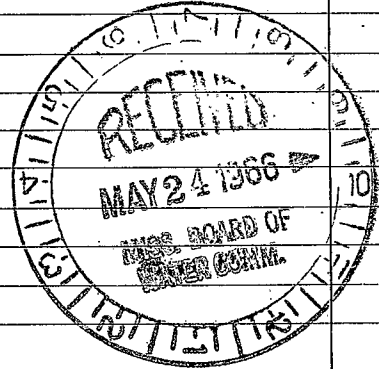

(Use Back Side)

Well No.

