

Lowndes  
G 105  
2-67

MISSISSIPPI  
 BOARD OF WATER COMMISSIONERS  
 416 North State Street  
 Jackson, Mississippi 39201

**CODED**

WATER WELL DRILLERS LOG

6-28 1968 W. J. REEVES & SON LOWNDES  
 date well completed firm name county well located  
 IRD. Part of Camp - Go to House R. - Then Turn L.

LANDOWNER: A. E. SHELTON

description of formations encountered	from to	
SANDY SOIL	0	9
SAND & GRAVEL	9	31
BLUE CLAY	31	34
" SAND	34	37
" CLAY	37	106
" SAND	106	115
" CLAY	115	146
" SAND	146	176
" CLAY	176	180

707 WARDATH RD.  
COLUMBUS, MISS.  
 (mailing address)

WELL LOCATION:  
 17<sup>0</sup> sec. 2 T. 18 S. R. 18 W.  
1 miles W of COLUMBUS  
 (distance) (direction) (nearest town)

WELL PURPOSE: CAMP HOUSE  
 (home, irrigation, municipal, industrial)

WELL COMPLETION DATA:

- (1) diameter (inches) 4
- (2) total depth (feet) 180
- (3) static water level (feet) 16 below top of ground.
- (4) casing STEEL, 42,  
 (material) (depth)  
4" if telescope see back.  
 (size)
- (5) screen NONE  
 (length) (depth to top)  
 (size) (material)
- (6) pump 1/2 15  
 (HP) (yield gpm)  
ELECT  
 (type power)
- (7) electric log NO  
 (yes or no)

(organization running log)

(8) how well bottom plugged OPEN

DRILLERS REMARKS:


**CODED**

MISS. BD. OF WATER COMM. 10-3-68

If well telescopes please sketch and show depths.

GROUND LEVEL

WELL LOCATED IN  
"URBAN AREA" ON  
RIVER

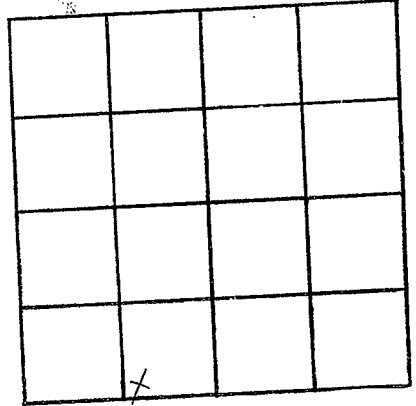

SECTION 17

Please indicate well location X.

ADDITIONAL INFORMATION

If more than one screen,  
show locations of each on sketch.