

LOWNDES MISSISSIPPI BOARD OF WATER COMMISSIONERS

G106
3-25-61

WATER WELL DRILLERS LOG

CODED 318

Date: 3-25-61, 1961, Driller: W. J. REEVES & SON County LOWNDES

4th St S 1128 11324

(Name)

(1) Owner of Land: DM. BAKER
373 3554 (Name)
COLUMBUS MISS
147 POPLAR (Address) 21 185 18W
 (2) Location: SE 1/4, 1/4, Sec. 12-T 48R 2W
IN CITY
 miles _____, of _____
 (distance) (direction) (Nearest Town)
 (3) Topography: HILLY
(Hilly) (Flat) (Level)
 (4) Purpose of Well: WORMS
(Domestic Irrigation Municipal, Industrial, Other)


Description & Color of Materials Sand, Clay, Red Clay, Shell, etc.	Thick-ness Feet	Depth Feet
CLAY	17	0
SAND & GRAVEL	20	17
BLUE CLAY	76	37
" SAND	14	113
" CLAY	26	127
" SAND	45	153

Information upon completion of well:

(1) Diameter 4 inches.
 (2) Total Depth 198 feet.
 (3) Water Level 34 feet below top of ground.
 (4) Cased to 40', Size 4"
 (5) Screen: Size _____, Length _____
 (6) Were any formations sealed against pollution?
 _____ yes, _____ no.

If YES depth of formation _____
 Why _____
 Drillers Remarks: _____

CODED

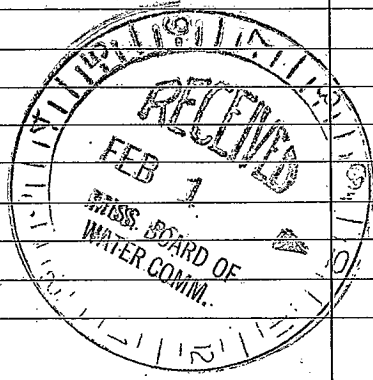

(Use Back Side)

Well No.

