

Lovender
G-112

MISSISSIPPI BOARD OF WATER COMMISSIONERS

CODED

7-66

WATER WELL DRILLERS LOG

Date: July, 1966, Driller: W. B. Clardy County Lovender
(Name)

(1) Owner of Land: C. A. Dodson
(Name)
Columbus, Miss.
Bennett P.O. 3287157 (Address)

(2) Location: NW SW NE $\frac{1}{4}$, Sec. 25 T105R100
185 18 W
1 miles (distance), 6 (direction), of Colo. (Nearest Town)

(3) Topography: flat
(Hilly) (Flat) (Level)

(4) Purpose of Well: Domestic
(Domestic Irrigation, Municipal, Industrial, Other)

Description & Color of Materials Sand, Clay, Red Clay, Shell, etc.	Thick-ness Feet	Depth Feet
<u>Sand + gravel</u>	<u>8'</u>	<u>21'</u>
<u>Blue Clay</u>	<u>21'</u>	<u>65'</u>
<u>Sand</u>	<u>65'</u>	<u>90'</u>
<u>Sandy streaks</u>	<u>110'</u>	<u>135'</u>
<u>streaks of blue clay in between</u>		

Information upon completion of well:

(1) Diameter 4 inches.

(2) Total Depth 135 feet.

(3) Water level 12 feet below top of ground.

(4) Cased to 42, Size 4"

(5) Screen: Size _____, Length _____


(6) Were any formations sealed against pollution?
_____ yes, _____ no.

If YES depth of formation _____

Why _____

Drillers Remarks: _____

CODED

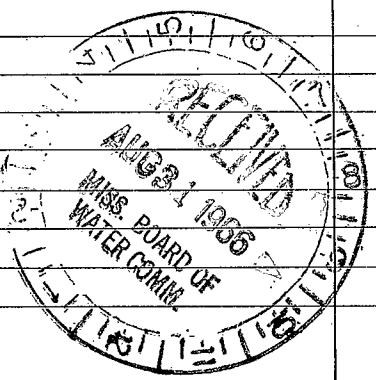

(Use Back Side)

Well No.

