

G 118  
5-63

**CODED**

**WATER WELL DRILLERS LOG**

Date: May, 1963, Driller: W. B. Clardy County Lowndes  
13547 (Name)

(1) Owner of Land: <u>Robert Malone</u> <small>(Name)</small>	Description & Color of Materials Sand, Clay, Red Clay, Shell, etc.	Thick- ness Feet	Depth Feet
<u>1911 College St.</u> <small>(Address)</small>	<u>8'-30' gravel + sand</u>		
(2) Location: <u>NE 1/4, SW 1/4, Sec. 15</u> <u>15</u> <u>T. 8 N. R. 16 W.</u>  _____ miles _____ of _____ <small>(distance) (direction) (Nearest Town)</small>	<u>30'-90' Blue rock</u>		
(3) Topography: <u>Level</u> <small>(Hilly) (Flat) (Level)</small>	<u>90'-120' sand</u>		
(4) Purpose of Well: <u>Domestic</u> <small>(Domestic Irrigation Municipal, Industrial, Other)</small>	<u>120'-150' Blue rock</u>		
	<u>150' - rock</u>		
	<u>150'-190' streak of sand</u>		

Information upon completion of well:


- (1) Diameter 4 inches.
- (2) Total Depth 190' feet.
- (3) Water Level \_\_\_\_\_ feet below top of ground.
- (4) Cased to 48', Size 4"
- (5) Screen: Size \_\_\_\_\_, Length \_\_\_\_\_
- (6) Were any formations sealed against pollution?  
\_\_\_\_\_ yes, \_\_\_\_\_ no.

If YES depth of formation \_\_\_\_\_

Why \_\_\_\_\_

Drillers Remarks: \_\_\_\_\_

**CODED**

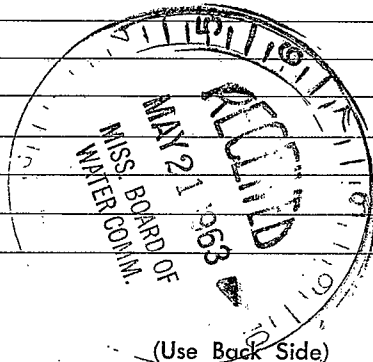

Well No.

