

LOWNDRS

G120

7-19-60

WATER WELL DRILLERS LOG

CODED

Date: July 19, 1960, Driller: W. B. Clardy County: Loundes  
(Name)  
LAST HOUSE ON LEFT SIDE Before turns to gravel Pit

(1) Owner of Land: Gordon Clarke  
(Name)  
9th St So. Columbus  
(Address)  
338 2099

(2) Location: SW SW 1/4, SE 1/4, Sec. 21 T. 18 S. R. 10 W.  
\_\_\_\_\_ miles \_\_\_\_\_ of \_\_\_\_\_  
(distance) (direction) (Nearest Town)

(3) Topography: \_\_\_\_\_  
(Hilly) (Flat) (Level)

(4) Purpose of Well: Domestic  
(Domestic Irrigation  
Municipal, Industrial, Other)

Description & Color of Materials Sand, Clay, Red Clay, Shell, etc.	Thick- ness Feet	Depth Feet
<u>Sand + Gravel</u>	<u>30'</u>	<u>to 50'</u>
<u>Blue Clay</u>	<u>50'</u>	<u>to 70'</u>
<u>Hard rock</u>	<u>70'</u>	
<u>Hard rock</u>	<u>78'</u>	
<u>blue Clay</u>	<u>78'</u>	<u>to 110'</u>
<u>grey sand</u>	<u>110'</u>	<u>to 115'</u>
<u>Clay</u>	<u>115'</u>	<u>to 164'</u>
<u>Sand</u>	<u>164'</u>	<u>to 182'</u>

Information upon completion of well:

(1) Diameter 4 inches.

(2) Total Depth 205 feet.


(3) Water Level 10 feet below top of ground.

(4) Cased to 82 ft, Size 4"  
126 ft, 2"

(5) Screen: Size \_\_\_\_\_, Length \_\_\_\_\_

(6) Were any formations sealed against pollution?  
\_\_\_\_\_ yes, \_\_\_\_\_ no.

CODED

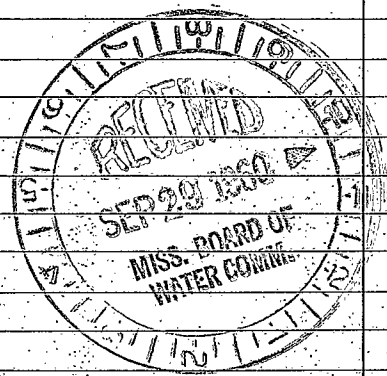

If YES depth of formation \_\_\_\_\_

Why \_\_\_\_\_

Drillers Remarks: \_\_\_\_\_

(Use Back Side)

Well No.

