

LOWNOES

G121
8-25-60

WATER WELL DRILLERS LOG

CODED

6304

Date: Aug. 25, 1960, Driller: W. B. Clardy County Lowndes
(Name)

107 Gaylane St.

Howard Jewell St.
(1) Owner of Land: M. J. Woolbright

(Name)

Daytone Subdivision
HW 55 328211 (Address)

(2) Location: SW 1/4, SE 1/4, Sec. 13, T18S, R18E

_____ miles _____ of _____
(distance) (direction) (Nearest Town)

(3) Topography: _____
(Hilly) (Flat) (Level)

(4) Purpose of Well: Domestic
(Domestic Irrigation, Municipal, Industrial, Other)

Description & Color of Materials Sand, Clay, Red Clay, Shell, etc.	Thick- ness Feet	Depth Feet
<u>Gravel - 15' to 20'</u>		
<u>Blue Clay - 20' to 60'</u>		
<u>Sand - 60' to 64'</u>		
<u>Blue Clay - 64' to 80'</u>		
<u>Sand - 80' to 85'</u>		
<u>Clay - 85' to 90'</u>		
<u>Sand - 90' to 94'</u>		

Information upon completion of well:

(1) Diameter 4 inches.

(2) Total Depth 100 feet.

(3) Water Level 10 feet below top of ground.

(4) Cased to 30'-8", Size 4"

(5) Screen: Size _____, Length _____

(6) Were any formations sealed against pollution?


_____ yes, _____ no.

If YES depth of formation _____

Why _____

Drillers Remarks: _____

CODED

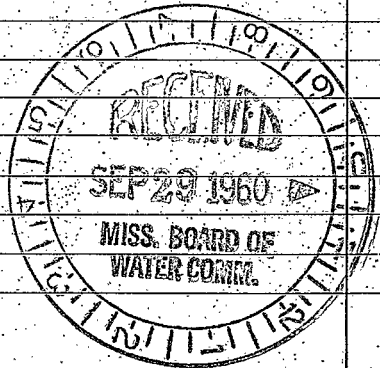

(Use Back Side)

Well No. 6304

