

Lowndes
 6122
 6-68

MISSISSIPPI
 BOARD OF WATER COMMISSIONERS
 416 North State Street
 Jackson, Mississippi 39201

CODED

WATER WELL DRILLERS LOG

Jame 1968 Clardy Well Drilling Lowndes
 date well completed firm name county well located

LANDOWNER:
 St. Matthew Baptist Church
 Columbus Miss.
 (mailing address)

description of fomations encountered	from	to
Sand & gravel	0	25
Sandy blue rock	25	65
hard bandy blue rock	65	90
Sandy blue Clay	90	120
rock	130	
Blue Clay	130	190
Sand & gravel	190	200

WELL LOCATION:
 30 sec. T. 18 N. R. 18 E.
 1 miles W of Colb.
 (distance) (direction) (nearest town)

WELL PURPOSE:
 (home, irrigation, municipal, industrial)

WELL COMPLETION DATA:

(1) diameter (inches) 4"

(2) total depth (feet) 200'

(3) static water level (feet) 16 below above top of ground.

(4) casing 4" 99 1/2'
 (material) (depth)
 _____ if telescope see back.
 (size)

(5) screen _____
 (length) (depth to top)
 (size) (material)

(6) pump 1/3 500 gph.
 (HP) (yield gpm)

 (type power)

(7) electric log No
 (yes or no)

 (organization running log)

(8) how well bottom plugged _____


CODED

JUL 15 1968
 MISS. BOARD OF
 WATER COMMISSIONERS

DRILLERS REMARKS:

If well telescopes please sketch and show depths.

GROUND LEVEL

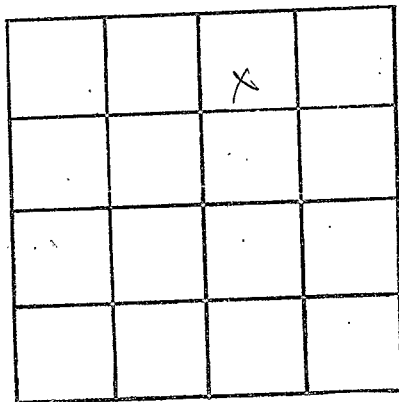

SECTION 30

Please indicate well location X.

ADDITIONAL INFORMATION

If more than one screen,
show locations of each on sketch.