

Lowndes

G123

12-11-71

MISSISSIPPI  
 BOARD OF WATER COMMISSIONERS  
 416 North State Street  
 Jackson, Mississippi 39201

WATER WELL DRILLERS LOG

12-11 date well completed

1971 W.J. REEVES & SON firm name

LOWNDES county well located

LANDOWNER: SHELTON CONT., INC.

632 31ST AVE. No.

COLUMBUS

(mailing address)

WELL LOCATION:

sec. 12 T. 18 S. R. 18 W.

1 miles E of COLUMBUS

(distance) (direction) (nearest town)

WELL PURPOSE: HOME  
(home, irrigation, municipal, industrial)

WELL COMPLETION DATA:

- (1) diameter (inches) 4
- (2) total depth (feet) 100
- (3) static water level (feet) 8 below above top of ground.
- (4) casing STEEL 3 1/2  
(material) (depth)
- 4  
(size) If telescope see back.
- (5) screen NONE  
(length) (depth to top)
- 4  
(size) (material)
- (6) pump 1/2 10  
(HP) (yield gpm)
- ELECT  
(type power)
- (7) electric log NO  
(yes or no)
- (organization running log)
- (8) how well bottom plugged OPEN

description of formations encountered

from

to


SANDY CLAY	0	8
SAND & GRAVEL	8	29
BLUE CLAY	29	58
BLUE SAND	58	64
BLUE CLAY	64	76
BLUE SAND	76	82
BLUE CLAY	82	86
BLUE SAND	86	100

DRILLERS REMARKS:

WELL 277 1572

If well telescopes please sketch and show depths.

GROUND LEVEL

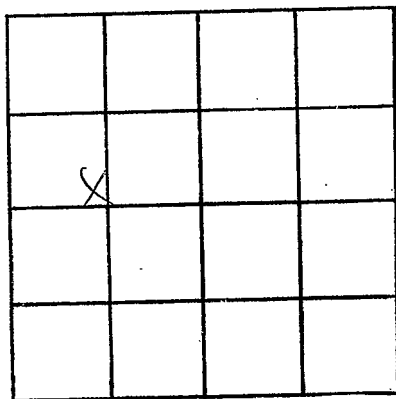

SECTION 12

Please indicate well location X.

ADDITIONAL INFORMATION

If more than one screen, show locations of each on sketch.