

LOWNDES

G 126

5-22-72

MISSISSIPPI
 BOARD OF WATER COMMISSIONERS
 416 North State Street
 Jackson, Mississippi 39201

CODED

WATER WELL DRILLERS LOG

5-22 1972 W. J. REEVES & SON LOWNDES
 date well completed firm name county well located

LANDOWNER: JARVIC WARD

SULLIVAN RD.

COLUMBUS

(mailing address)

WELL LOCATION:

sec. 12 T. 18 N. R. 18 W.
 S. 4
 1 miles E of Columbus
 (distance) (direction) (nearest town)

WELL PURPOSE: HOME
 (home, irrigation, municipal, industrial)

WELL COMPLETION DATA:

- (1) diameter (inches) 4
- (2) total depth (feet) 120
- (3) static water level (feet) 8 below above top of ground.
- (4) casing STEEL, 38 (material) (depth)
 4 (size) if telescope see back.
- (5) screen NONE (length) (depth to top)
 (size) (material)
- (6) pump 1/2 (HP) 10 (yield gpm)
 ELECT (type power)
- (7) electric log NO (yes or no)
 (organization running log)
- (8) how well bottom plugged OPEN

description of formations encountered

from

to

CLAY	0	8
SAND	8	17
SAND & GRAVEL	17	28
BLUE CLAY	28	31
BLUE SAND	31	33
BLUE CLAY	33	56
BLUE SAND	56	63
BLUE CLAY	63	87
BLUE SAND	87	116
BLUE CLAY	116	120

CODED


JUN 21 1972

MISS. BD. OF
WATER COM.

DRILLERS REMARKS:

If well telescopes please sketch and show depths.

GROUND LEVEL

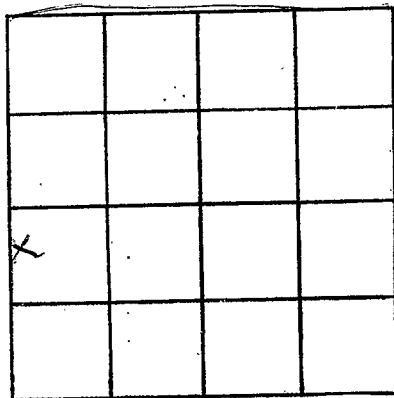

SECTION 12

Please indicate well location X.

ADDITIONAL INFORMATION

If more than one screen, show locations of each on sketch.