

LOWNDES
G129
5-72

MISSISSIPPI
 BOARD OF WATER COMMISSIONERS
 416 North State Street
 Jackson, Mississippi 39201

CODED

WATER WELL DRILLERS LOG

5/27/72 19 Clardy Well & Pump Service Lowndes
 date well completed firm name county well located

LANDOWNER: Leicelle Brewer

description of formations encountered

from

to

Highway 69

clay

0

5

Columbus, Miss
 (mailing address)

sand + gravel

5

20

blue clay

20

40

streaks sand + clay

40

50

blue clay

50

53

streaks sand + clay

53

65

blue clay

65

74

streaks sand + clay

74

85

blue clay

85

90

sandy clay

90

100

blue clay

100

110

COILED sand

110

115

COILED sand

115

135

WELL LOCATION:

sec. 26 T. 18 N. R. 12 E. W
2 mi. miles SE of Columbus
 (distance) (direction) (nearest town)

WELL PURPOSE: Home
 (home, irrigation, municipal, industrial)

WELL COMPLETION DATA:

- diameter (inches) 4"
- total depth (feet) 135
- static water level (feet) 2 below / above top of ground.
- casing Steel Casing 31
 (material) (depth)
4" if telescope see back.
 (size)
- screen _____
 (length) (depth to top)

 (size) (material)
- pump 1/3 Sub. 8
 (HP) (yield gpm)
Electric
 (type power)
- electric log no
 (yes or no)


 (organization running log)
- how well bottom plugged _____

DRILLERS REMARKS:

MISSISSIPPI 53 1972

If well telescopes please sketch and show depths.

GROUND LEVEL

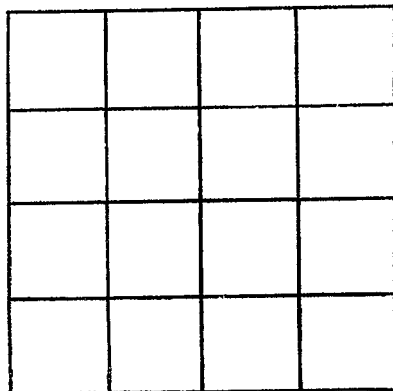

SECTION _____

Please indicate well location X.

ADDITIONAL INFORMATION

If more than one screen,
show locations of each on sketch.