

LOWNDES  
G132  
6-8-72

MISSISSIPPI  
BOARD OF WATER COMMISSIONERS  
416 North State Street  
Jackson, Mississippi 39201

**CODED**

WATER WELL DRILLERS LOG

6-8 1972 W.S. REEVES & SON LOWNDES  
date well completed firm name county well located

LANDOWNER: W.C. SWAYTON

YORKVILLE RD.

COLUMBUS  
(mailing address)

WELL LOCATION:

sec. 14 T. 14 N R. 18 E  
0 miles of COLUMBUS  
(distance) (direction) (nearest town)

WELL PURPOSE: HOME  
(home, irrigation, municipal, industrial)

WELL COMPLETION DATA:

- (1) diameter (inches) 4
- (2) total depth (feet) 160
- (3) static water level (feet) 15 below above top of ground.
- (4) casing STEEL, 40 (material), (depth), 4 (size) if telescope see back.
- (5) screen NONE (length), (depth to top)
- (6) pump 1/2 (HP), 10 (material), (yield gpm)  
ELECT (type power)
- (7) electric log No (yes or no)
- (organization running log)
- (8) how well bottom plugged OPEN

description of formations encountered

from

to

CLAY	0	8
SAND & GRAVEL	8	27
BLUE CLAY	27	31
BLUE SAND	31	36
BLUE CLAY	36	88
BLUE SAND	88	95
BLUE CLAY	95	128
BLUE SAND	128	152
BLUE CLAY	152	157
BLUE SAND	157	160

**CODED**


NOV 11 1972

DRILLERS REMARKS:

MISS. BD. OF  
GEOLOGICAL SURVEY

If well telescopes please sketch and show depths.

GROUND LEVEL

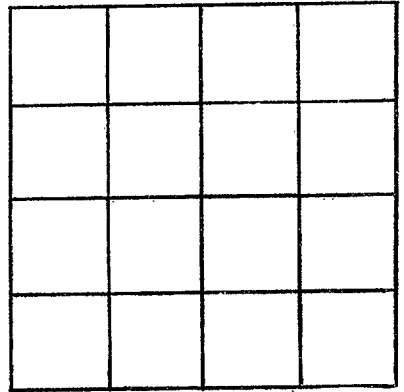

SECTION \_\_\_\_\_

Please indicate well location X.

ADDITIONAL INFORMATION

If more than one screen, show locations of each on sketch.