

LOWNDES
G137
11-25-72

MISSISSIPPI
 BOARD OF WATER COMMISSIONERS
 416 North State Street
 Jackson, Mississippi 39201

CODED

WATER WELL DRILLERS LOG

Nov 25 1972 Claydy well + pump serv. Lowndes
 date well completed firm name county well located

LANDOWNER:	description of formations encountered	from	to
<u>James Strickland</u>			
<u>Route 2</u>	<u>red clay</u>	<u>0</u>	<u>5</u>
<u>Columbus, Miss</u> (mailing address)	<u>sand + gravel</u>	<u>5</u>	<u>16</u>
	<u>blue clay</u>	<u>16</u>	<u>23</u>
	<u>rocks + fine sand</u>	<u>23</u>	<u>38</u>
	<u>blue clay</u>	<u>38</u>	<u>55</u>
	<u>sandy blue clay + rocks</u>	<u>55</u>	<u>68</u>
	<u>sandy blue clay</u>	<u>68</u>	<u>80</u>
	<u>blue clay</u>	<u>80</u>	<u>90</u>
	<u>sandy blue clay</u>	<u>90</u>	<u>100</u>
	<u>blue clay</u>	<u>100</u>	<u>120</u>
	<u>sand</u>	<u>120</u>	<u>135</u>

WELL LOCATION:

sec. 1 T. 18 N. R. 18 W.
2 miles NE of Columbus
 (distance) (direction) (nearest town)

WELL PURPOSE:
 (home, irrigation, municipal, industrial)

WELL COMPLETION DATA:


- (1) diameter (inches) 4"
- (2) total depth (feet) 135
- (3) static water level (feet) 8' below top of ground.
- (4) casing steel, 4.3'
 (material) (depth)
- _____ if telescope see back.
 (size)
- (5) screen _____ (length) _____ (depth to top)
 _____ (size) _____ (material)
- (6) pump _____ (HP) _____ (yield gpm)
 _____ (type power)
- (7) electric log _____ (yes or no)
 _____ (organization running log)
- (8) how well bottom plugged _____

JAN 17 1973

DRILLERS REMARKS: Pump installed by customer

If well telescopes please sketch and show depths.

GROUND LEVEL

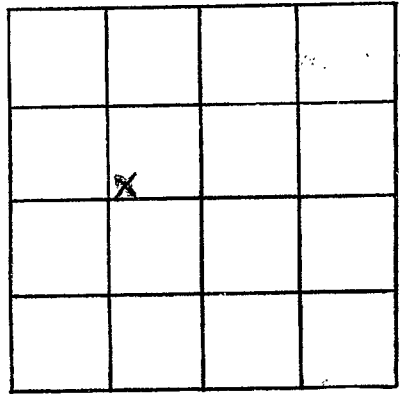

SECTION 1

Please indicate well location X.

ADDITIONAL INFORMATION

If more than one screen,
show locations of each on sketch.