

LOWNDES
G 139
12-16-72

West

MISSISSIPPI
 BOARD OF WATER COMMISSIONERS
 416 North State Street
 Jackson, Mississippi 39201

CODE

WATER WELL DRILLERS LOG

Dec 16 1972 CLARDY Well + Pump Lowndes
 date well completed firm name county well located

LANDOWNER: Joseph Logan

description of formations encountered

from to

Hy. 69 South
Columbus, Miss
 (mailing address)

red clay	0	5
sand + gravel	5	20
blue clay	20	35
sandy blue clay	35	55
blue clay	55	70
sandy blue clay	70	85
blue clay	85	95
sandy blue clay	95	105
blue clay	105	120
fine sand + clay	120	135
blue clay	135	155
sand	155	170

NW WELL LOCATION:
 sec. 26 T. 18 N. R. 18 W.
 S. W.
1 miles S.E. of Col
 (distance) (direction) (nearest town)

WELL PURPOSE:
 (home, irrigation, municipal, industrial)

WELL COMPLETION DATA:


- (1) diameter (inches) 4
- (2) total depth (feet) 170
- (3) static water level (feet) 16 below above top of ground.
- (4) casing steel 64
 (material) (depth)
- _____ if telescope see back.
 (size)
- (5) screen _____
 (length) (depth to top)
- _____ (size) _____ (material)
- (6) pump 1/3 Sub 8
 (HP) (yield gpm)
- _____ (type power)
- (7) electric log _____
 (yes or no)
- _____ (organization running log)
- (8) how well bottom plugged _____

DATE: DEC 26 1972

DRILLERS REMARKS:

If well telescopes please sketch and show depths.

GROUND LEVEL

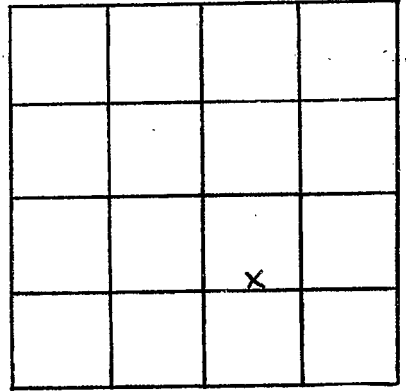

SECTION 26

Please indicate well location X.

ADDITIONAL INFORMATION

If more than one screen,
show locations of each on sketch.