

LOWNDES
G 141
3-2-73

MISSISSIPPI
 BOARD OF WATER COMMISSIONERS
 416 North State Street
 Jackson, Mississippi 39201

WATER WELL DRILLERS LOG **CODED**

Mar 2 1973 Clardy Well + pump Lowndes
 date well completed firm name county well located

LANDOWNER: Mr. Clint Dean
Clardy Drive
Columbus, Miss
 (mailing address)

description of formations encountered	from	to
sand	0	10
sand + gravel	10	25
blue clay	25	30
fine sand + rocks	30	45
blue clay	45	75
sandy clay	75	90
course sand	90	100

WELL LOCATION:
 sec. 12 T. 18 N. R. 18 E.
 S W
1 miles E of Columbus
 (distance) (direction) (nearest town)

WELL PURPOSE: home
 (home, irrigation, municipal, industrial)

WELL COMPLETION DATA:


- diameter (inches) 4"
- total depth (feet) 100
- static water level (feet) 8 below above top of ground.
- casing 4" steel, 53',
 (material) (depth)
 (size) if telescope see back.
- screen _____
 (length) (depth to top)
 (size) (material)
- pump 1/2 hp Sub 12
 (HP) (yield gpm)
 (type power)
- electric log _____
 (yes or no)
 (organization running log)
- how well bottom plugged D

DRILLERS REMARKS: _____

CODED

If well telescopes please sketch and show depths.

GROUND LEVEL

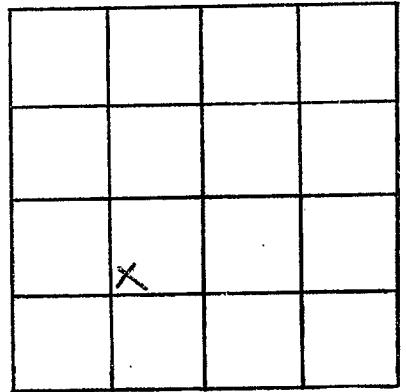

SECTION 12

Please indicate well location X.

ADDITIONAL INFORMATION

If more than one screen,
show locations of each on sketch.