

LOWNDES
G 142
3-23-73

MISSISSIPPI
 BOARD OF WATER COMMISSIONERS
 416 North State Street
 Jackson, Mississippi 39201

CODED

WATER WELL DRILLERS LOG

Mar 23 1973 Clardy Well Pump Lounds
 date well completed firm name county well located

LANDOWNER:	description of formations encountered	from	to
<u>Yowell</u>	<u>sand</u>	<u>0</u>	<u>10</u>
<u>Clardy Drive</u>	<u>sand + gravel</u>	<u>10</u>	<u>25</u>
<u>Columbus, Miss</u>	<u>blue clay</u>	<u>25</u>	<u>40</u>
(mailing address)	<u>fine sand + rocks</u>	<u>40</u>	<u>50</u>
	<u>blue clay</u>	<u>50</u>	<u>80</u>
	<u>sandy clay</u>	<u>80</u>	<u>100</u>
	<u>course sand</u>	<u>100</u>	<u>110</u>

WELL LOCATION:
 sec. 12 T. 18 N. R. 18 W.
1 miles E of Columbus
 (distance) (direction) (nearest town)

WELL PURPOSE: home
 (home, irrigation, municipal, industrial)

WELL COMPLETION DATA:


- (1) diameter (inches) 4"
- (2) total depth (feet) 110
- (3) static water level (feet) 9 below top of ground.
- (4) casing 4" steel, 58,
 (material) (depth)
 (size) if telescope see back.
- (5) screen _____
 (length) (depth to top)
 (size) (material)
- (6) pump 1/2 hp Sub 12
 (HP) (yield gpm)
 (type power)
- (7) electric log _____
 (yes or no)
 (organization running log)
- (8) how well bottom plugged

CODED

DRILLERS REMARKS: _____

If well telescopes please sketch and show depths.

GROUND LEVEL

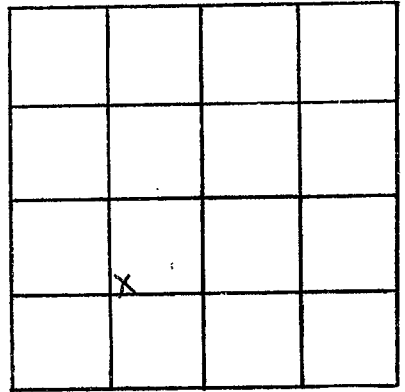

SECTION 12

Please indicate well location X.

ADDITIONAL INFORMATION

If more than one screen,
show locations of each on sketch.