

LOWNDES
G 147
5-26-73

MISSISSIPPI
 BOARD OF WATER COMMISSIONERS
 416 North State Street
 Jackson, Mississippi 39201

CODED

WATER WELL DRILLERS LOG

May 26 1973 Clardy Well Pump Loude
 date well completed firm name county well located

LANDOWNER: Washington Saffore

description of formations encountered

from to

Hughes Rd

clay 0 10

sand + gravel 10 35

sandy blue clay 35 40

blue clay 40 47

sandy blue clay 47 50

blue clay 50 70

fine sand + rocks 70 85

blue clay 85 110

sandy blue clay 110 125

blue clay 125 135

fine sand 135 145

blue clay 145 175

streaks of coarse sand + clay 175 200

(mailing address)

WELL LOCATION:

sec. 12 T 18 N R. 18 W

_____ miles _____ of _____
 (distance) (direction) (nearest town)

WELL PURPOSE: home
 (home, irrigation, municipal, industrial)

WELL COMPLETION DATA:

(1) diameter (inches) 4"

(2) total depth (feet) 200

(3) static water level (feet) 22 below
 top of ground

(4) casing 4" steel, 58'
 (material) (depth)

_____ if telescope see back.
 (size)

(5) screen 0 _____
 (length) (depth to top)

_____ (size) _____ (material)

(6) pump 1/2 sub 12
 (HP) (yield gpm)

_____ (type power)

(7) electric log _____
 (yes or no)

_____ (organization running log)

(8) how well bottom plugged open

CODED


JUN 21 1973

DRILLERS REMARKS:

MISS. Bd. of
 WATER COMMISSIONERS

If well telescopes please sketch and show depths.

GROUND LEVEL

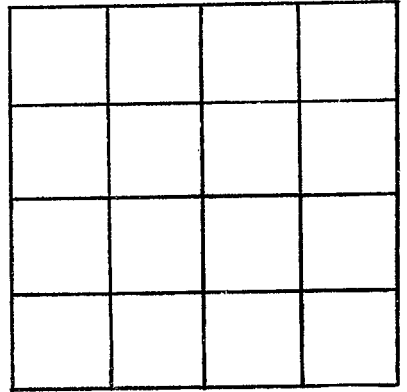

SECTION _____

Please indicate well location X.

ADDITIONAL INFORMATION

If more than one screen, show locations of each on sketch.