

Rth for loc
for

**MISSISSIPPI
BOARD OF WATER COMMISSIONERS**
416 North State Street
Jackson, Mississippi 39201

CODED

WATER WELL DRILLERS LOG

LOWNDES
G148
6-8-73

June 8 1973 Clard Well Pump Lowndes
date well completed firm name county well located

LANDOWNER: William Howell
Yorkville Rd
(mailing address)

WELL LOCATION:
NE 27 T 18 N R 18 E
NS sec S W
2 miles S of Fel
(distance) (direction) (nearest town)

description of formations encountered	from	to
clay	0	5
sand + gravel	5	12
blue clay	12	80
sandy clay	80	110
streaks of fine sand	110	140
clay		
sand	140	155

WELL PURPOSE: home
(home, irrigation, municipal, industrial)


- WELL COMPLETION DATA:**
- (1) diameter (inches) 4"
 - (2) total depth (feet) 155
 - (3) static water level (feet) 4 below top of ground. above
 - (4) casing 4" steel, 40,
(material) (depth)
 - (size) If telescope see back.
 - (5) screen Ø,
(length) (depth to top)
 - (size) (material)
 - (6) pump 1/2 sub 12
(HP) (yield gpm)
 - (type power)
 - (7) electric log _____
(yes or no)
 - (organization running log)
 - (8) how well bottom plugged Open

CODED

DRILLERS REMARKS: JUN 21 1973

If well telescopes please
sketch and show depths.

GROUND LEVEL

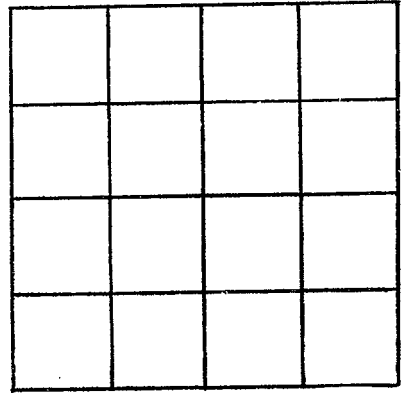

SECTION _____

Please indicate well location X.

ADDITIONAL INFORMATION

If more than one screen,
show locations of each on sketch.