

# 31202

**CODED**

**G 152**  
**LOWNDES**  
**7-31-73**

MISSISSIPPI  
BOARD OF WATER COMMISSIONERS  
416 North State Street  
Jackson, Mississippi 39201

**WATER WELL DRILLERS LOG**

July 31 1973 Clardy Well Pump Lowndes  
date well completed firm name county well located

OWNER: W.A. Dailey  
201 Curtis Road  
Columbus, Miss  
(mailing address)

| description of formations encountered | from | to  |
|---------------------------------------|------|-----|
| clay                                  | 0    | 7   |
| sand & gravel                         | 7    | 20  |
| blue clay                             | 20   | 50  |
| sandy blue clay                       | 50   | 80  |
| blue clay                             | 80   | 95  |
| sand                                  | 95   | 115 |

WELL LOCATION:  
sec. 12 T 18 N R 18 E  
1 miles E of Cal  
(distance) (direction) (nearest town)

WELL PURPOSE: home  
(home, irrigation, municipal, industrial)


- WELL COMPLETION DATA:
- (1) diameter (inches) 4
  - (2) total depth (feet) 115
  - (3) static water level (feet) 10 below/above top of ground.
  - (4) casing steel (material), 32 (depth)
  - \_\_\_\_\_ If telescope see back. (size)
  - (5) screen \_\_\_\_\_ (length), \_\_\_\_\_ (depth to top)
  - \_\_\_\_\_ (size), \_\_\_\_\_ (material)
  - (6) pump 1/2 sub (HP), 10 (yield gpm)
  - \_\_\_\_\_ (type power)
  - (7) electric log \_\_\_\_\_ (yes or no)
  - \_\_\_\_\_ (organization running log)
  - (8) how well bottom plugged 0

DRILLERS REMARKS:

**Aug 19 1973**

If well telescopes please  
sketch and show depths.

GROUND LEVEL

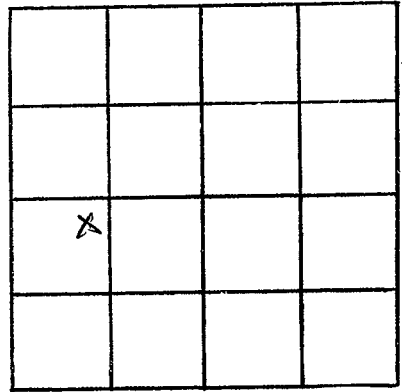

SECTION 12

Please indicate well location X.

ADDITIONAL INFORMATION

If more than one screen,  
show locations of each on sketch.